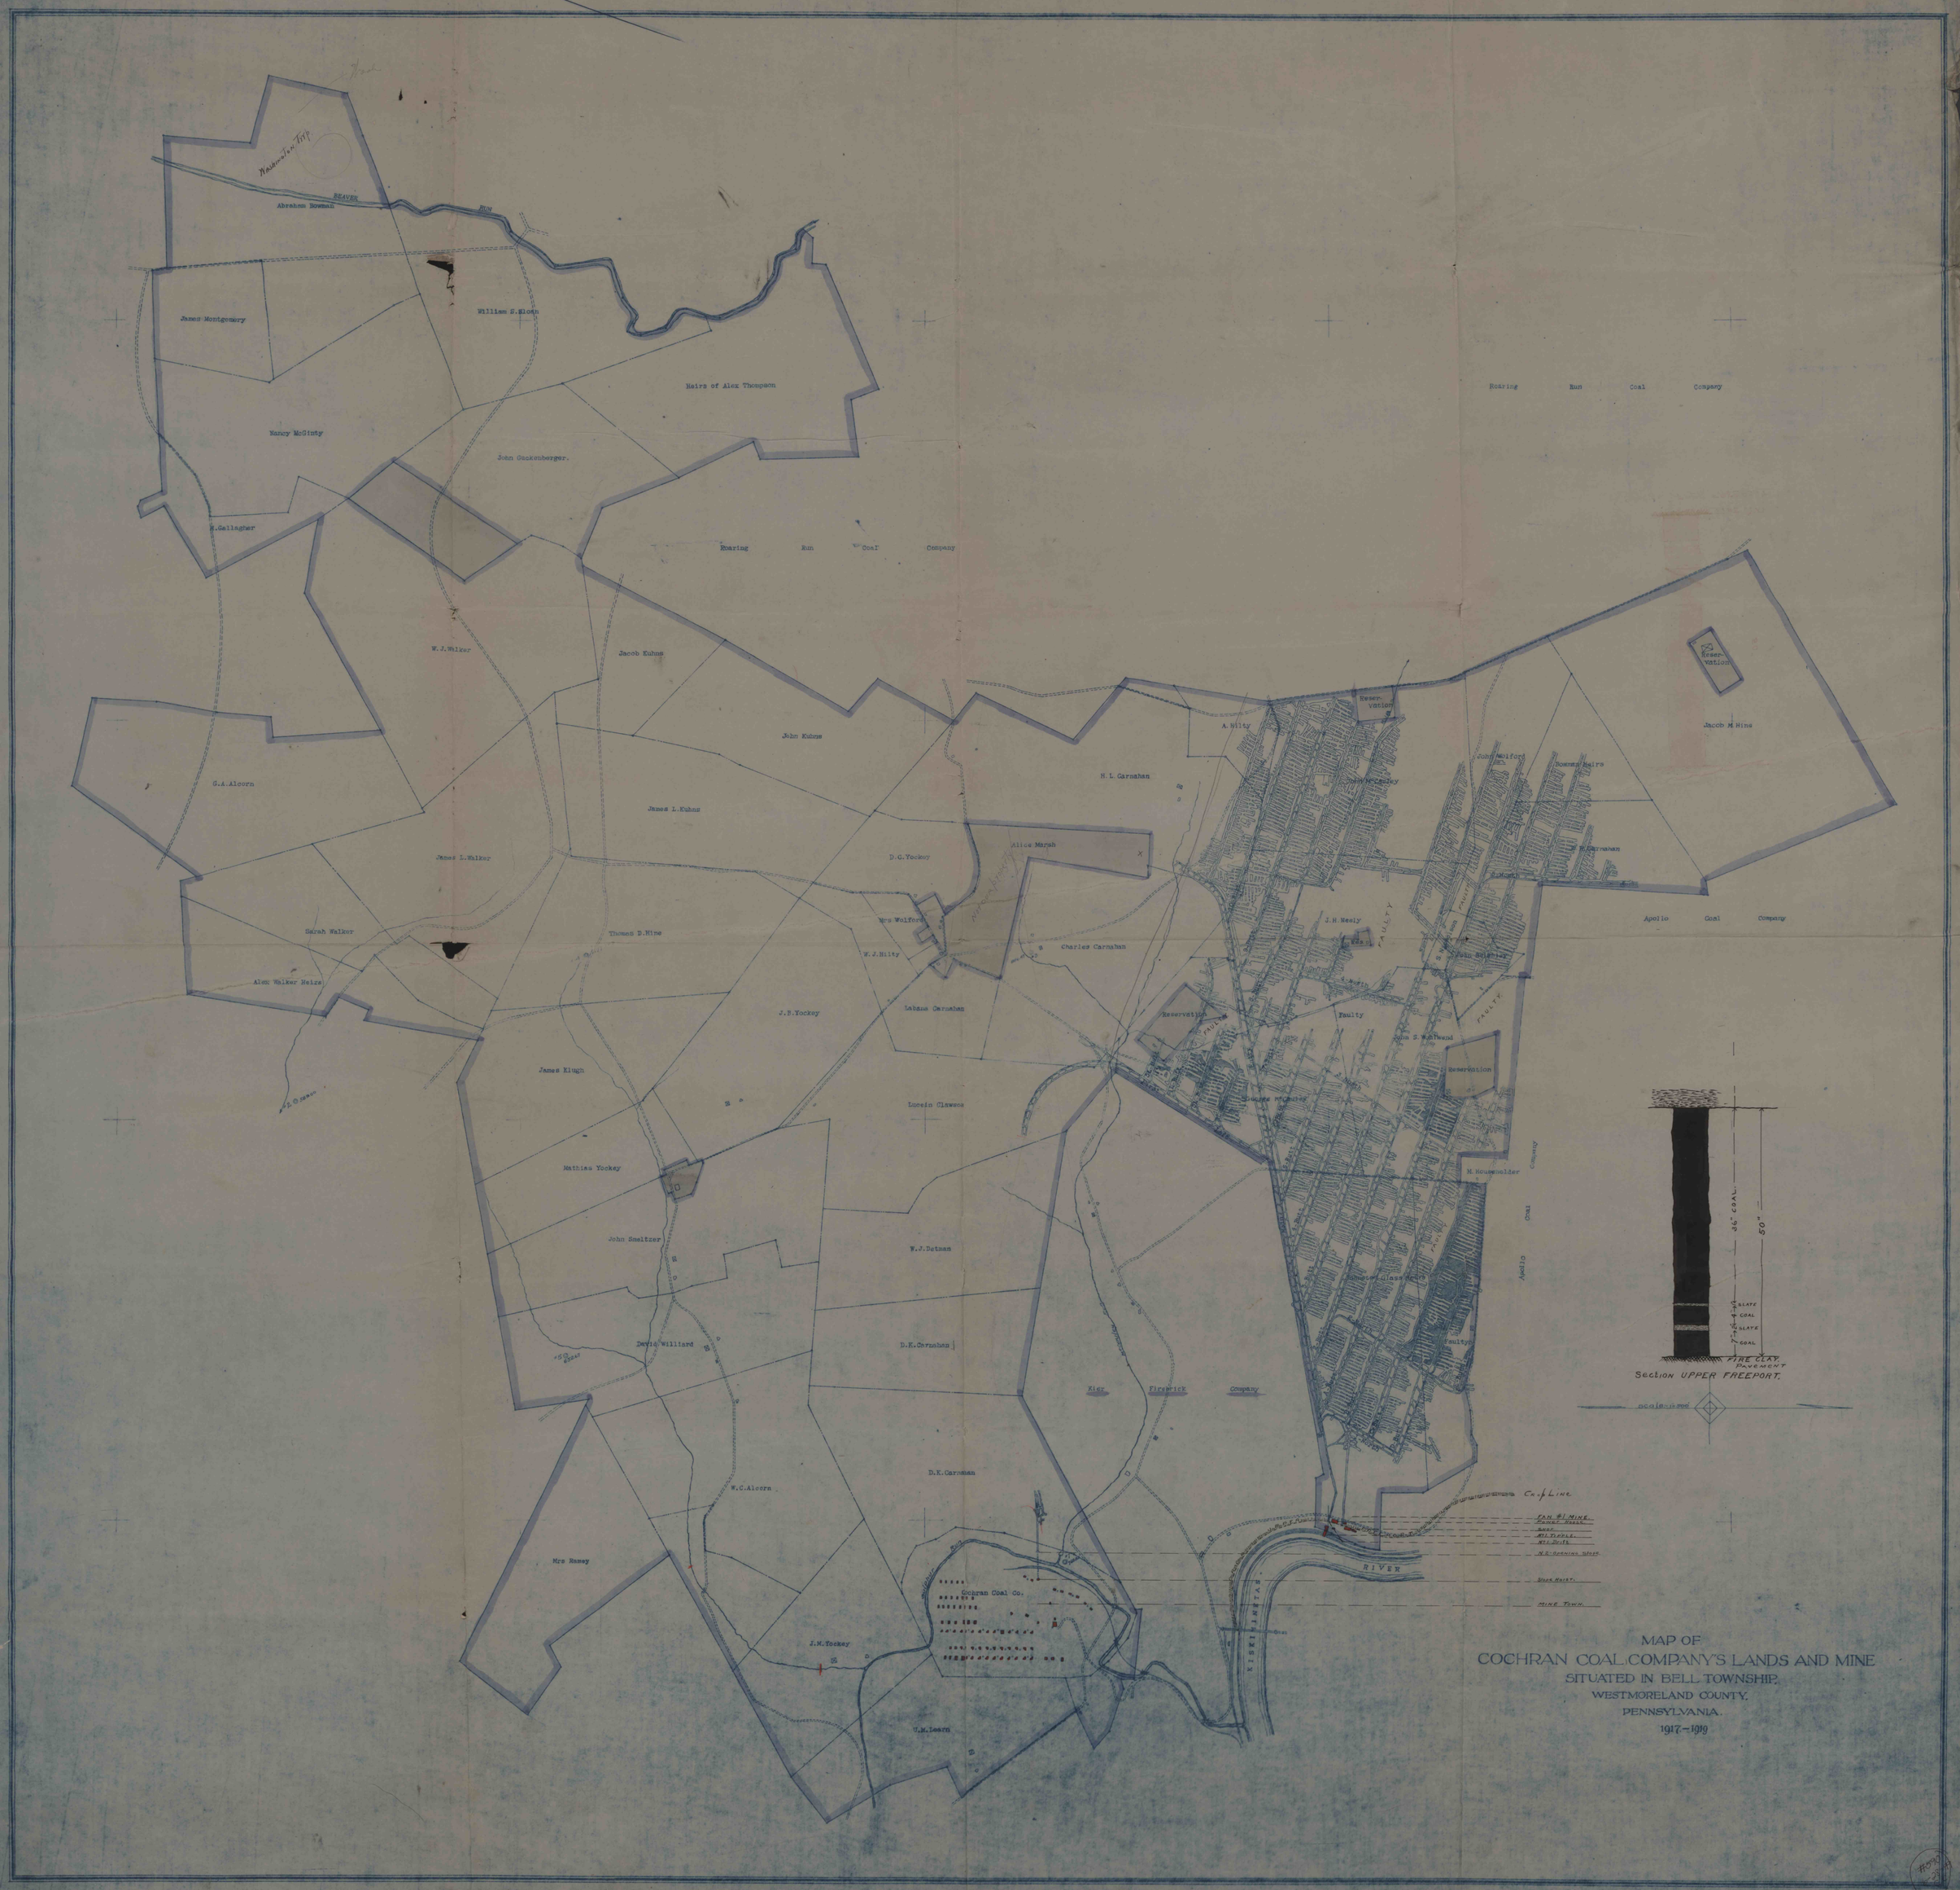

MAP OF
COCHRAN COAL COMPANY'S LANDS AND MINE
SITUATED IN BELL TOWNSHIP,
WESTMORELAND COUNTY,
PENNSYLVANIA.
1917–1919