


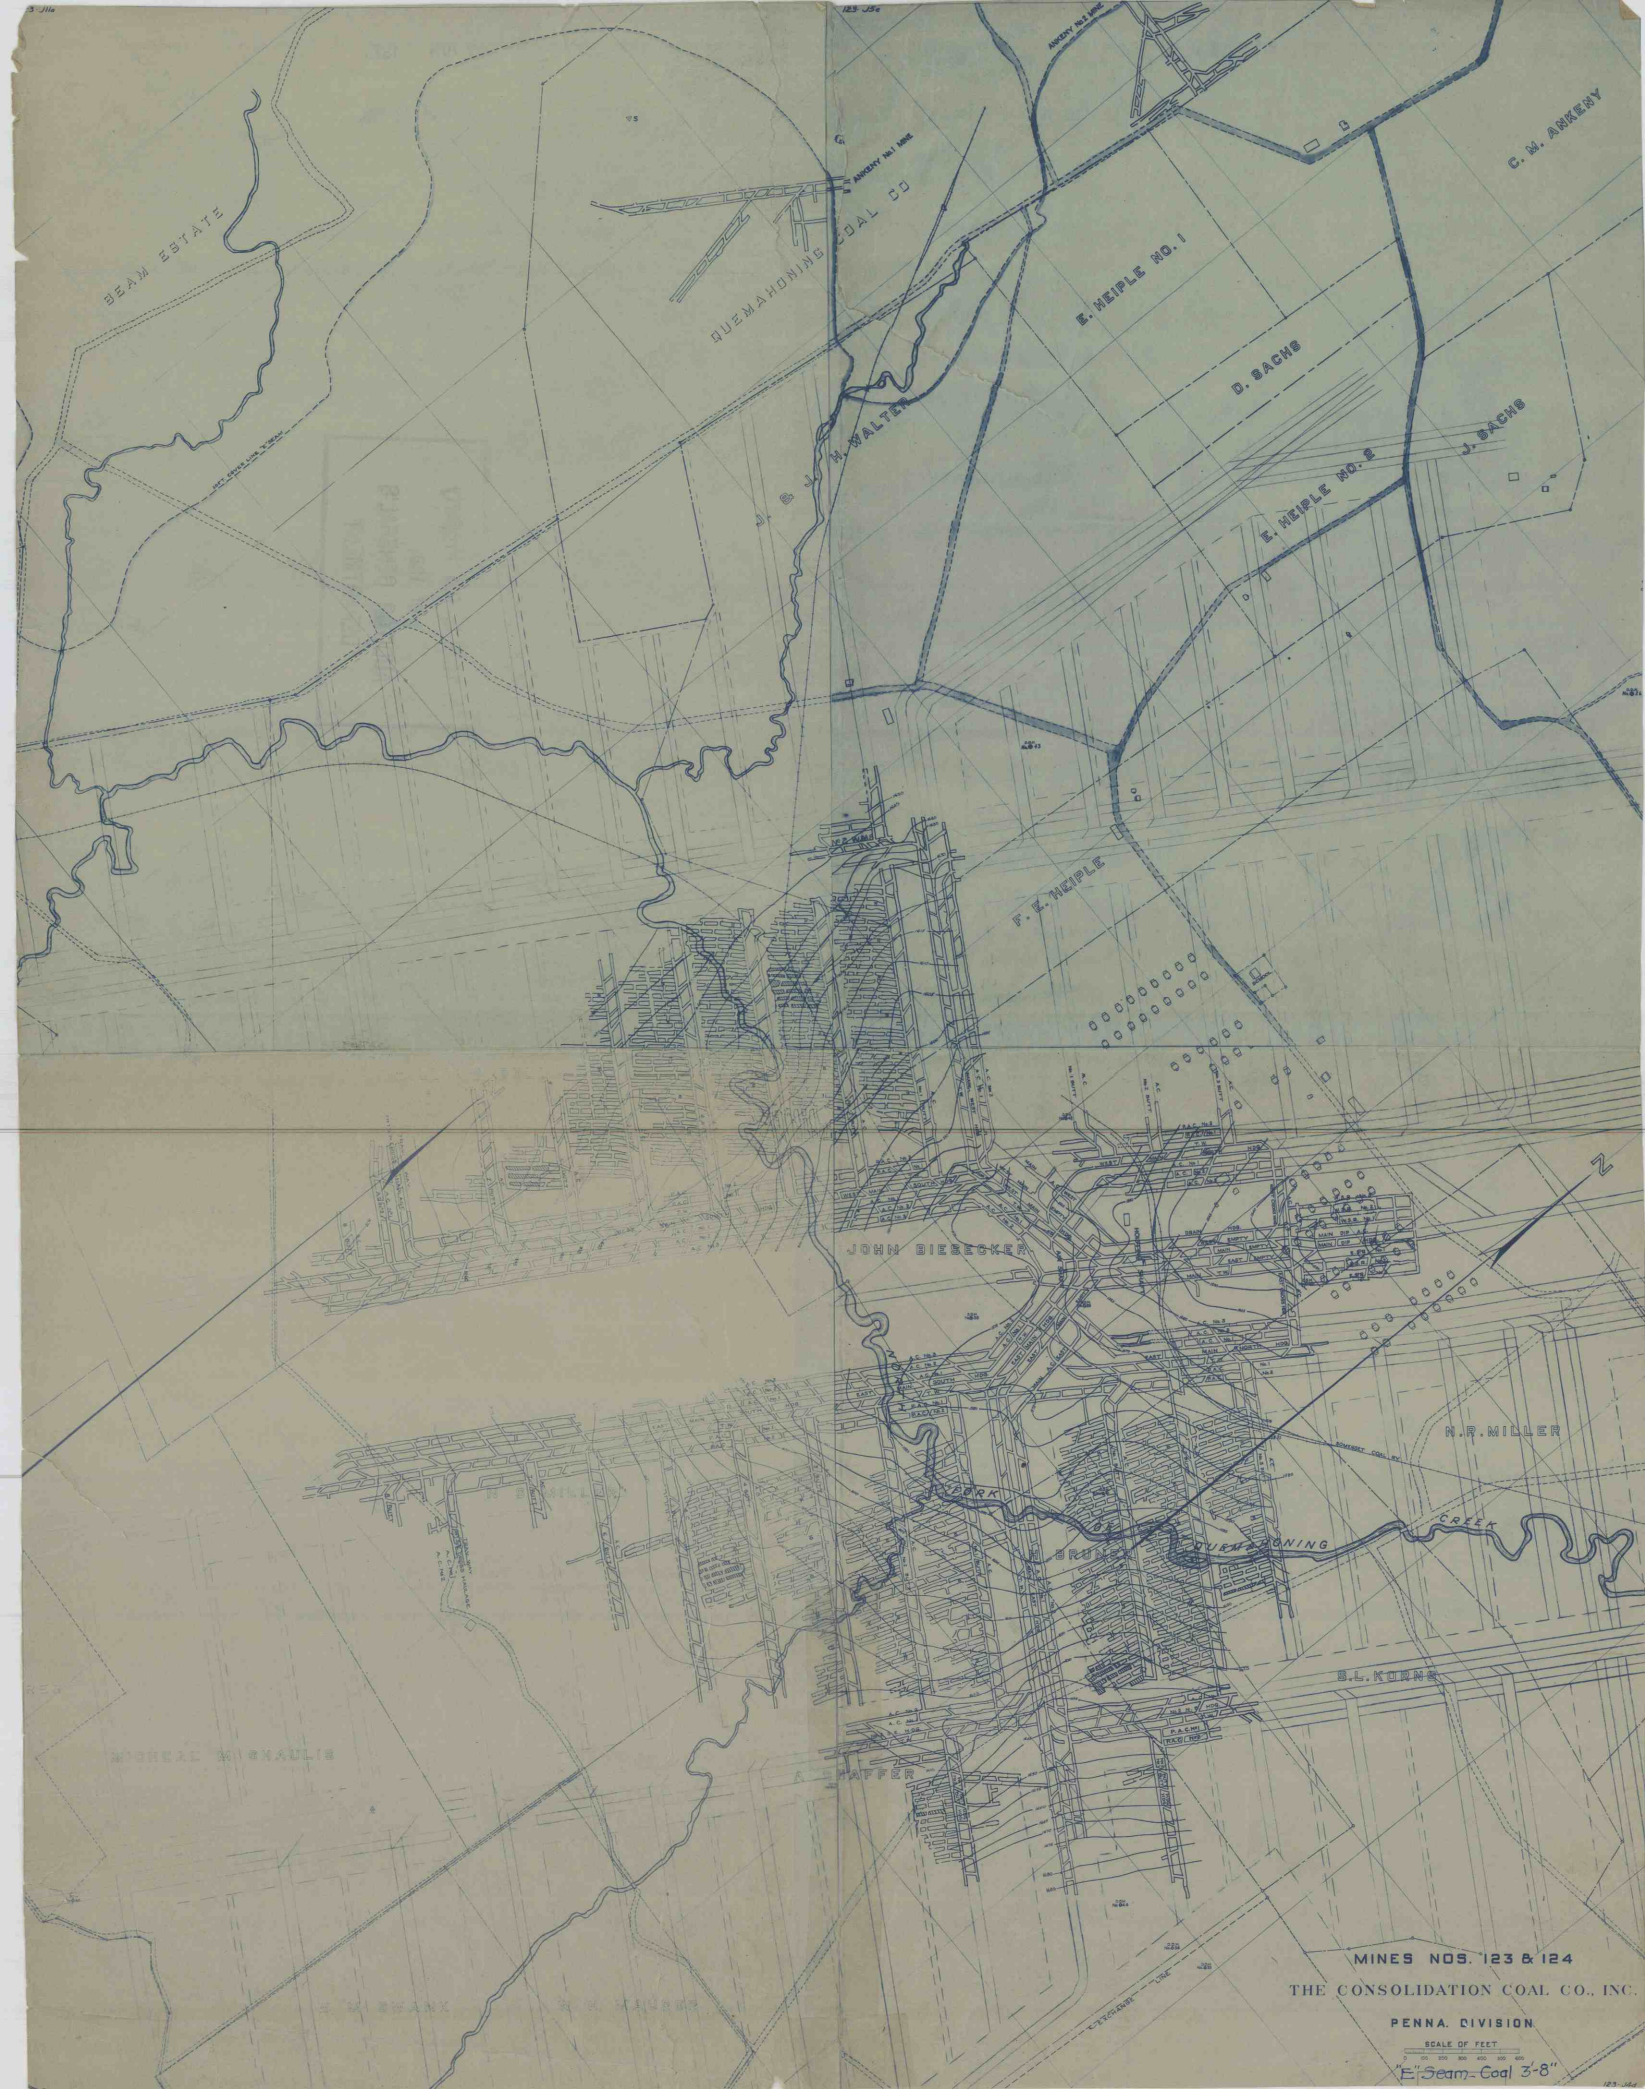

MINES NOS. 123 & 124
THE CONSOLIDATION COAL CO., INC.
PENNA. DIVISION
SCALE OF FEET
E. Seam - Coal 3'-8"