

#637  
6-30-99  
C.C.

MINE NO. 125  
THE CONSOLIDATION COAL CO., INC.  
PENNA. DIVISION  
SCALE OF FEET  
C' Seam - Coal 4'-0"



JONATHAN SNYDER  
189.06 AS.

MARY WALKER  
43.61 AS.

NOAH A. BAKER  
124.34 AS.


BEAM ESTATE

JOHN BITNER  
151.02 AS.

W.H. LOUGH  
132.23 AS.

J.A. FRIEDLINE  
148.40 AS.

J.A. ARSMANN  
73.48 AS.

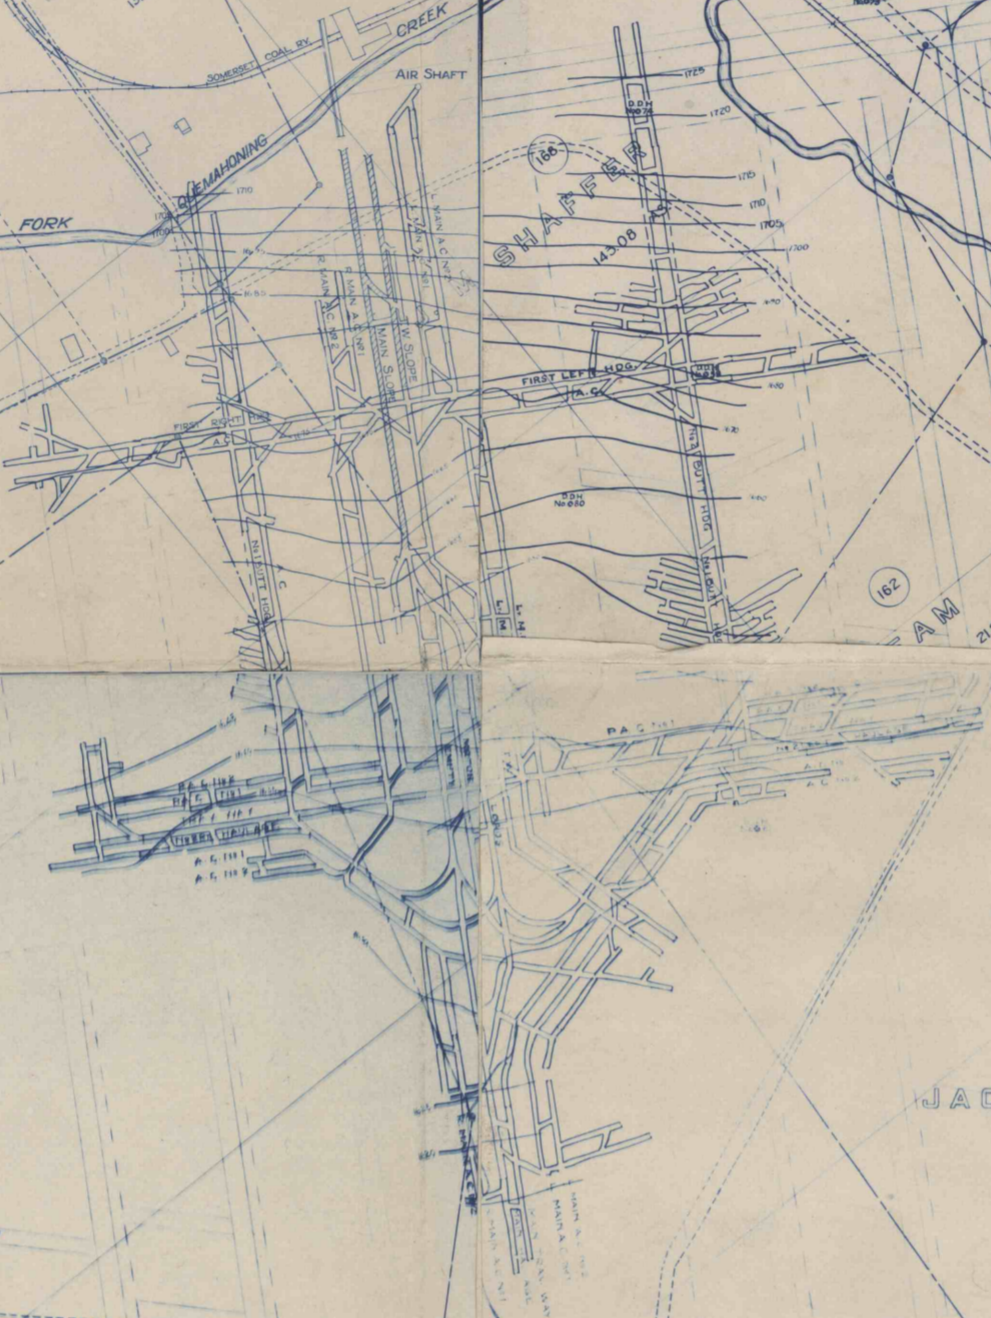

A. FREIDLINE  
172.74 AS.

JACOB & JEROME YODER  
100.44 AS.

A. FREIDLINE

WILLIS ANKENY  
204.71 AS.

L. G. ANKENY  
163.77 AS.

A. T. STAHL  
516.0 AS.

W. H. MAURER

JOHN KLINE  
162.00 AS.

D. BARNETT NO. 3  
95.33 AS.

MICHAEL M. SHAULIS  
111.73 AS.

J. ANKENY  
370.1 AS.

MORRIS SPEICHER  
171.31 AS.