




I Certify That This is a True and  
 Complete Copy of the Final M.V.  
 of Delmont Resources Inc. Delmont  
 Mine, 1" = 500' as Required by Section  
 OF PENNSYLVANIA FOR UNDERGROUND MINES".

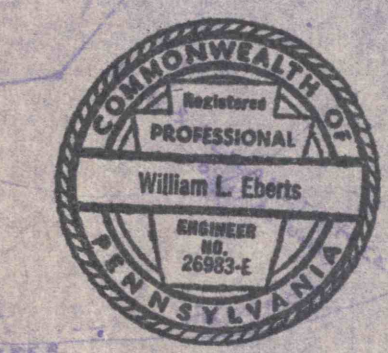

DELONT MINE I.D. No. 36-06598  
 VENTILATION UPDATE  
 SCALE: 1" = 500'  
 P.W. DATE: ~~11-27-84~~

*William L. Elmer*  
 11-27-84

**VENTILATION MAP**

POSTED TO: \_\_\_\_\_

DRAWN BY	DATE	DELONT MINE	SCALE: 1" = 500'
CHECKED BY		I.D. No. 36-06598	BMD - Cabinet M
APPROVED		PROJECTION IN	Drawer 2
		UPPER FREEPORT SEAM	

Previously Eastern Assoc.  
 Coal Corp.

#773  
 7-199  
 CC