


FIELD COPY

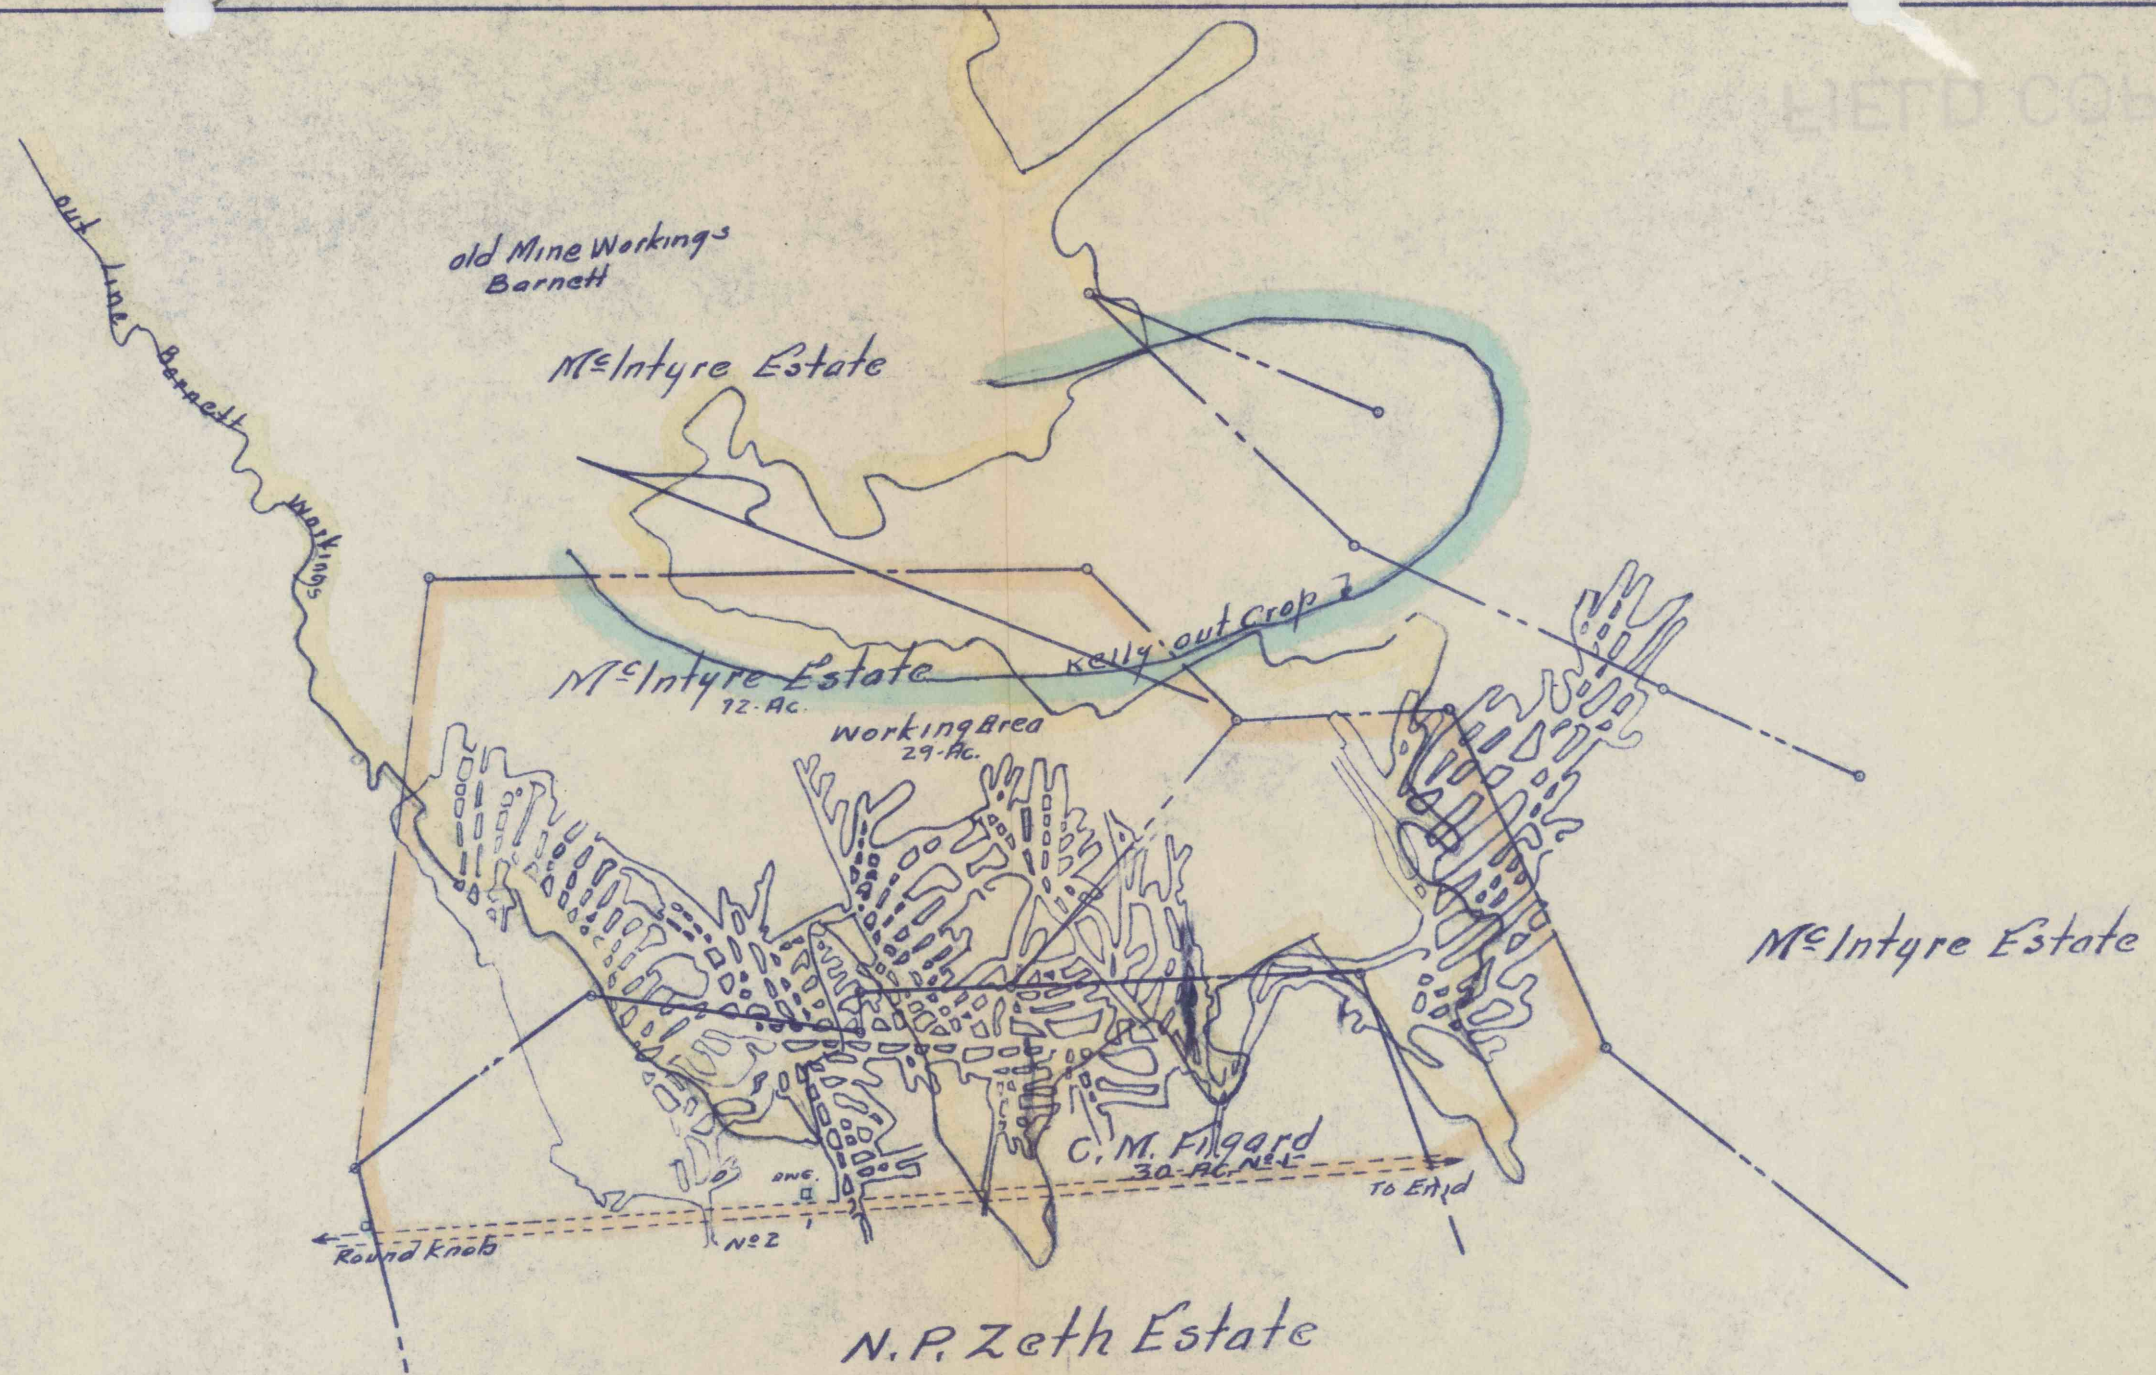

Map Showing Boundary of Figard No one Mine operated By Ritchey Brothers Coal Co. Situated In Broad Top Twp. Bedford County Pennsylvania Aug - 1966 E. Corrie Engr. 1" = 500'