


FIELD COPY

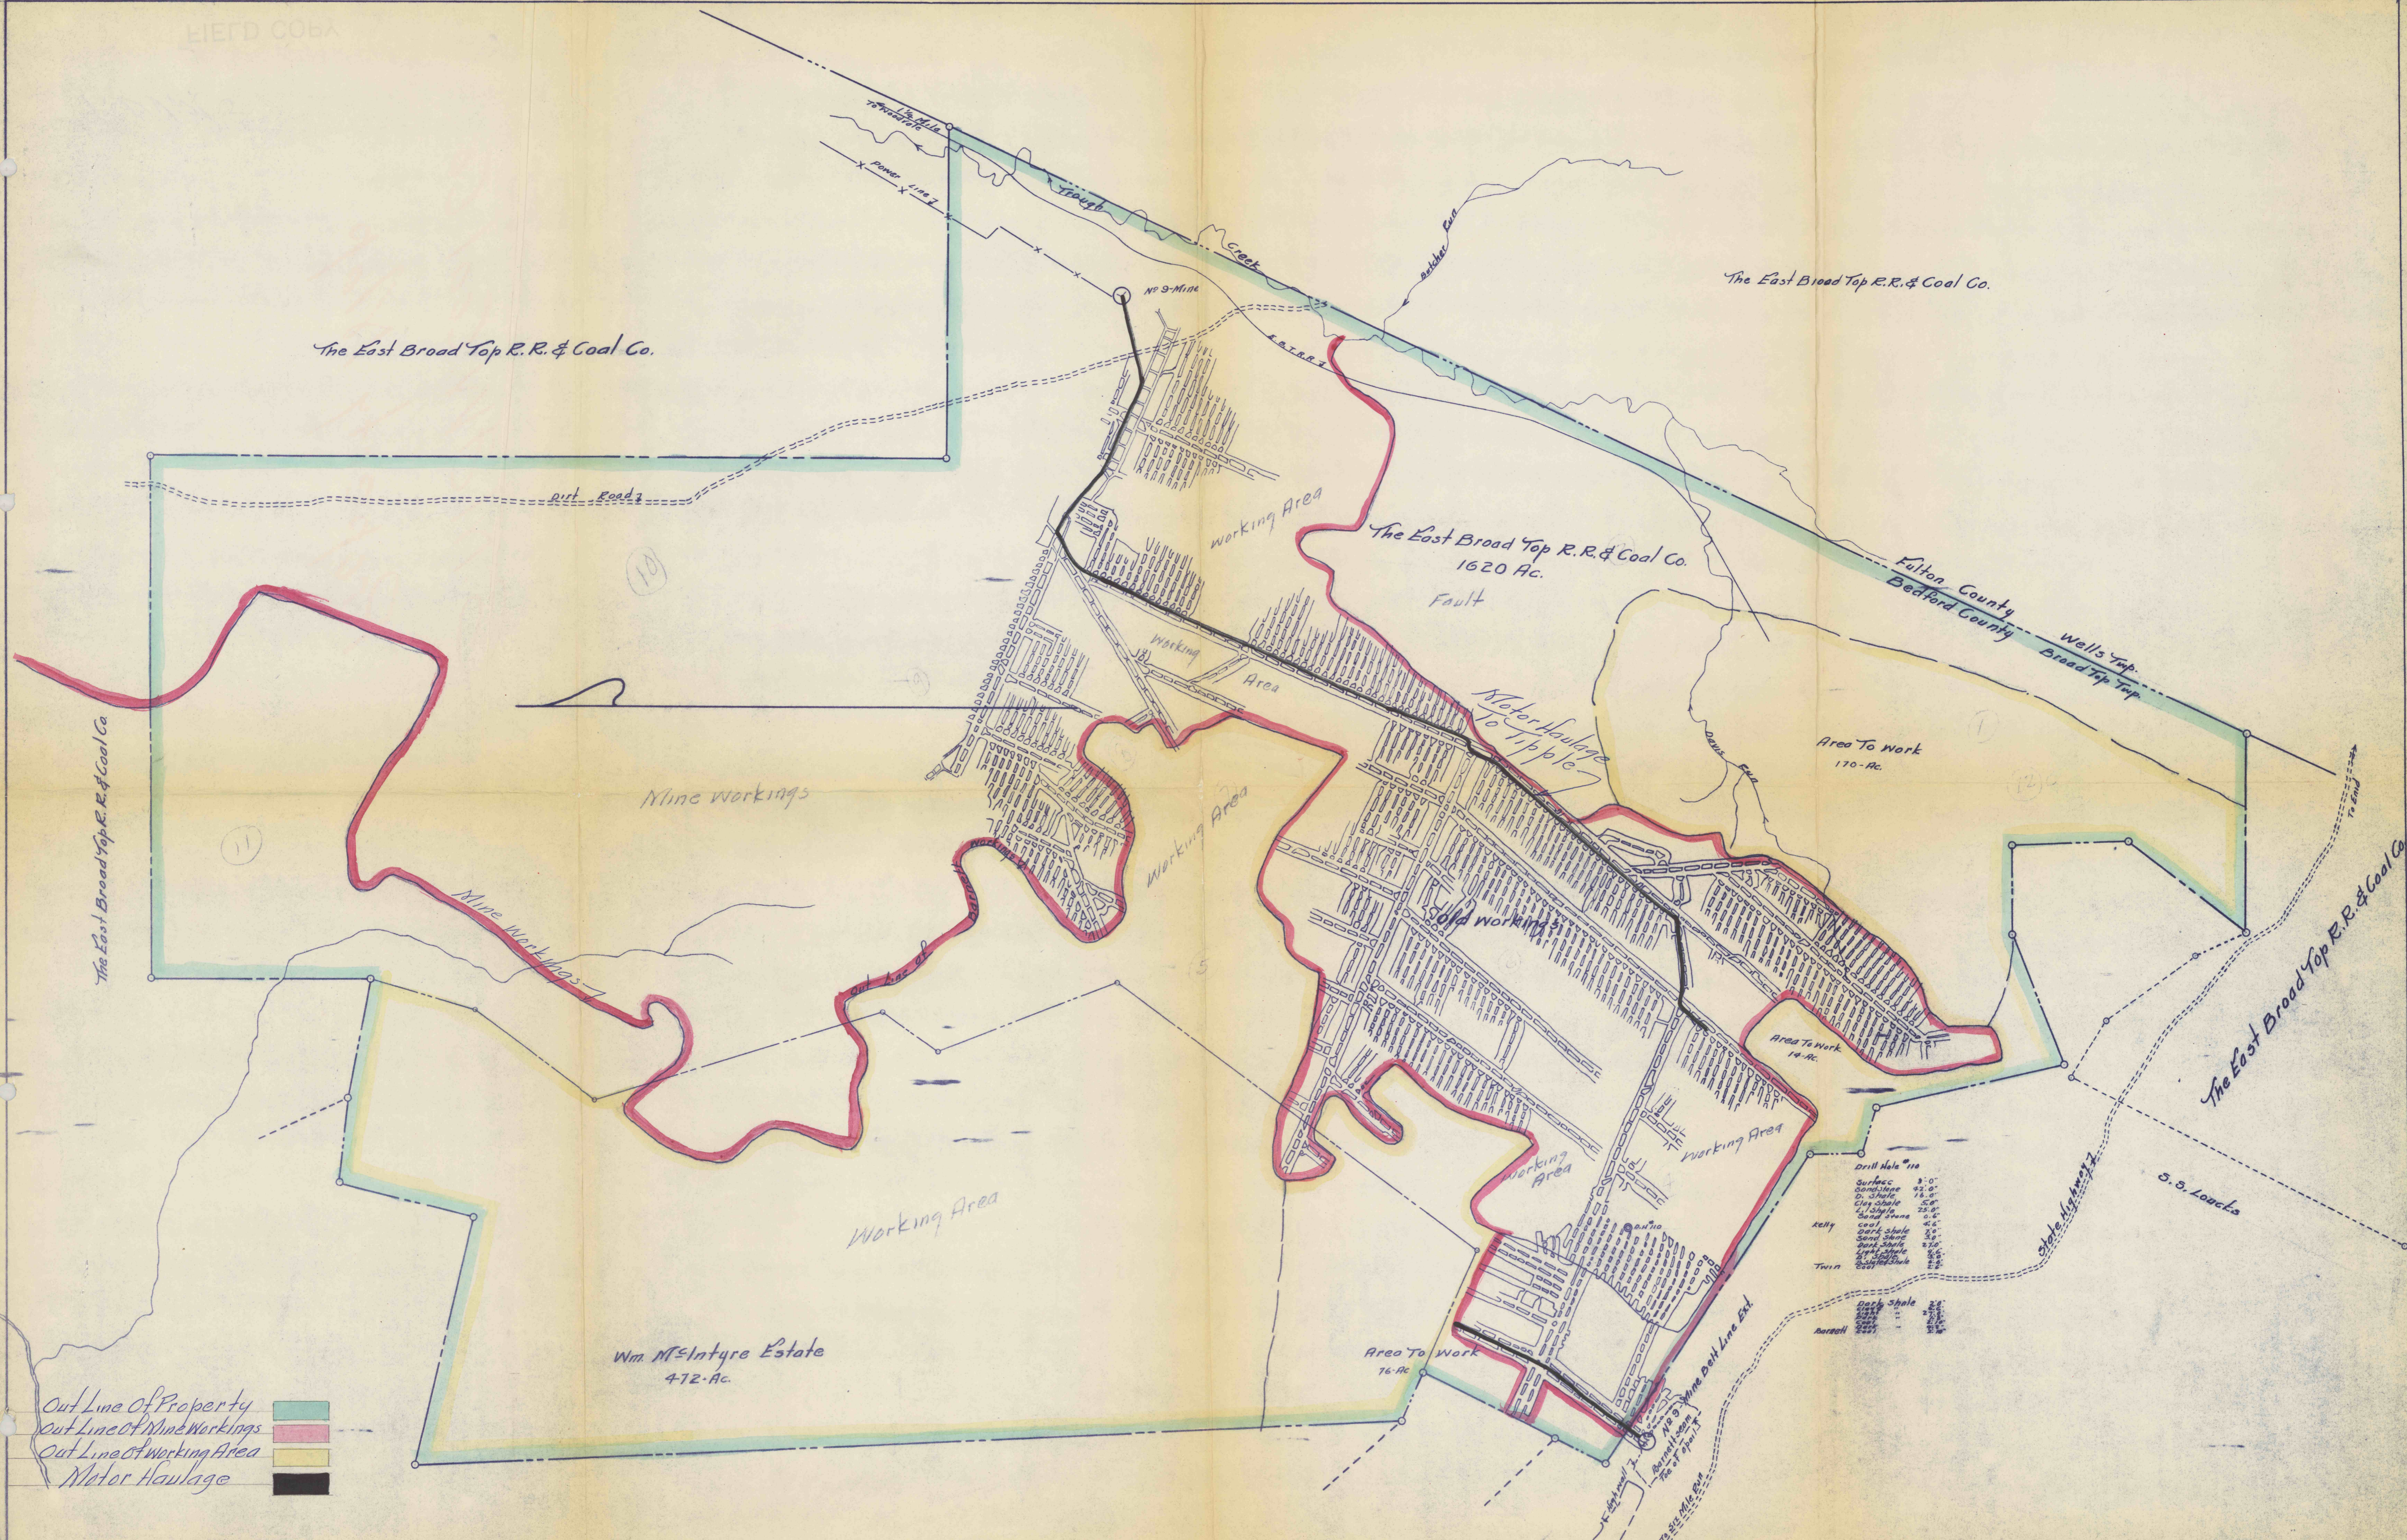

The East Broad Top R.R. & Coal Co.

The East Broad Top R.R. & Coal Co.

The East Broad Top R.R. & Coal Co.
1620 Ac.

Fulton County
Bedford County
Wells Twp.
Broad Top Twp.

Area To Work
170 Ac.

Mine workings

Working Area

Solid workings

Area To Work
14 Ac.

Working Area

Wm McIntyre Estate
472 Ac.

Area To Work
76 Ac.

Drill Hole #10

Surface	0.0'
Sandstone	15.0'
Clay shale	25.0'
Limestone	28.0'
Coal	30.0'
Dark shale	32.0'
Sandstone	35.0'
Dark shale	38.0'
Clay shale	40.0'

Out Line of Property
 Out Line of Mine Workings
 Out Line of Working Area
 Motor Haulage

Map Showing Property Leased By G.M. & W. Coal Company Situated In Broad Top Twp. Bedford County Pennsylvania Aug. 1966 E. Corrie Engr. 1" = 500'