


Palmer

Ralph

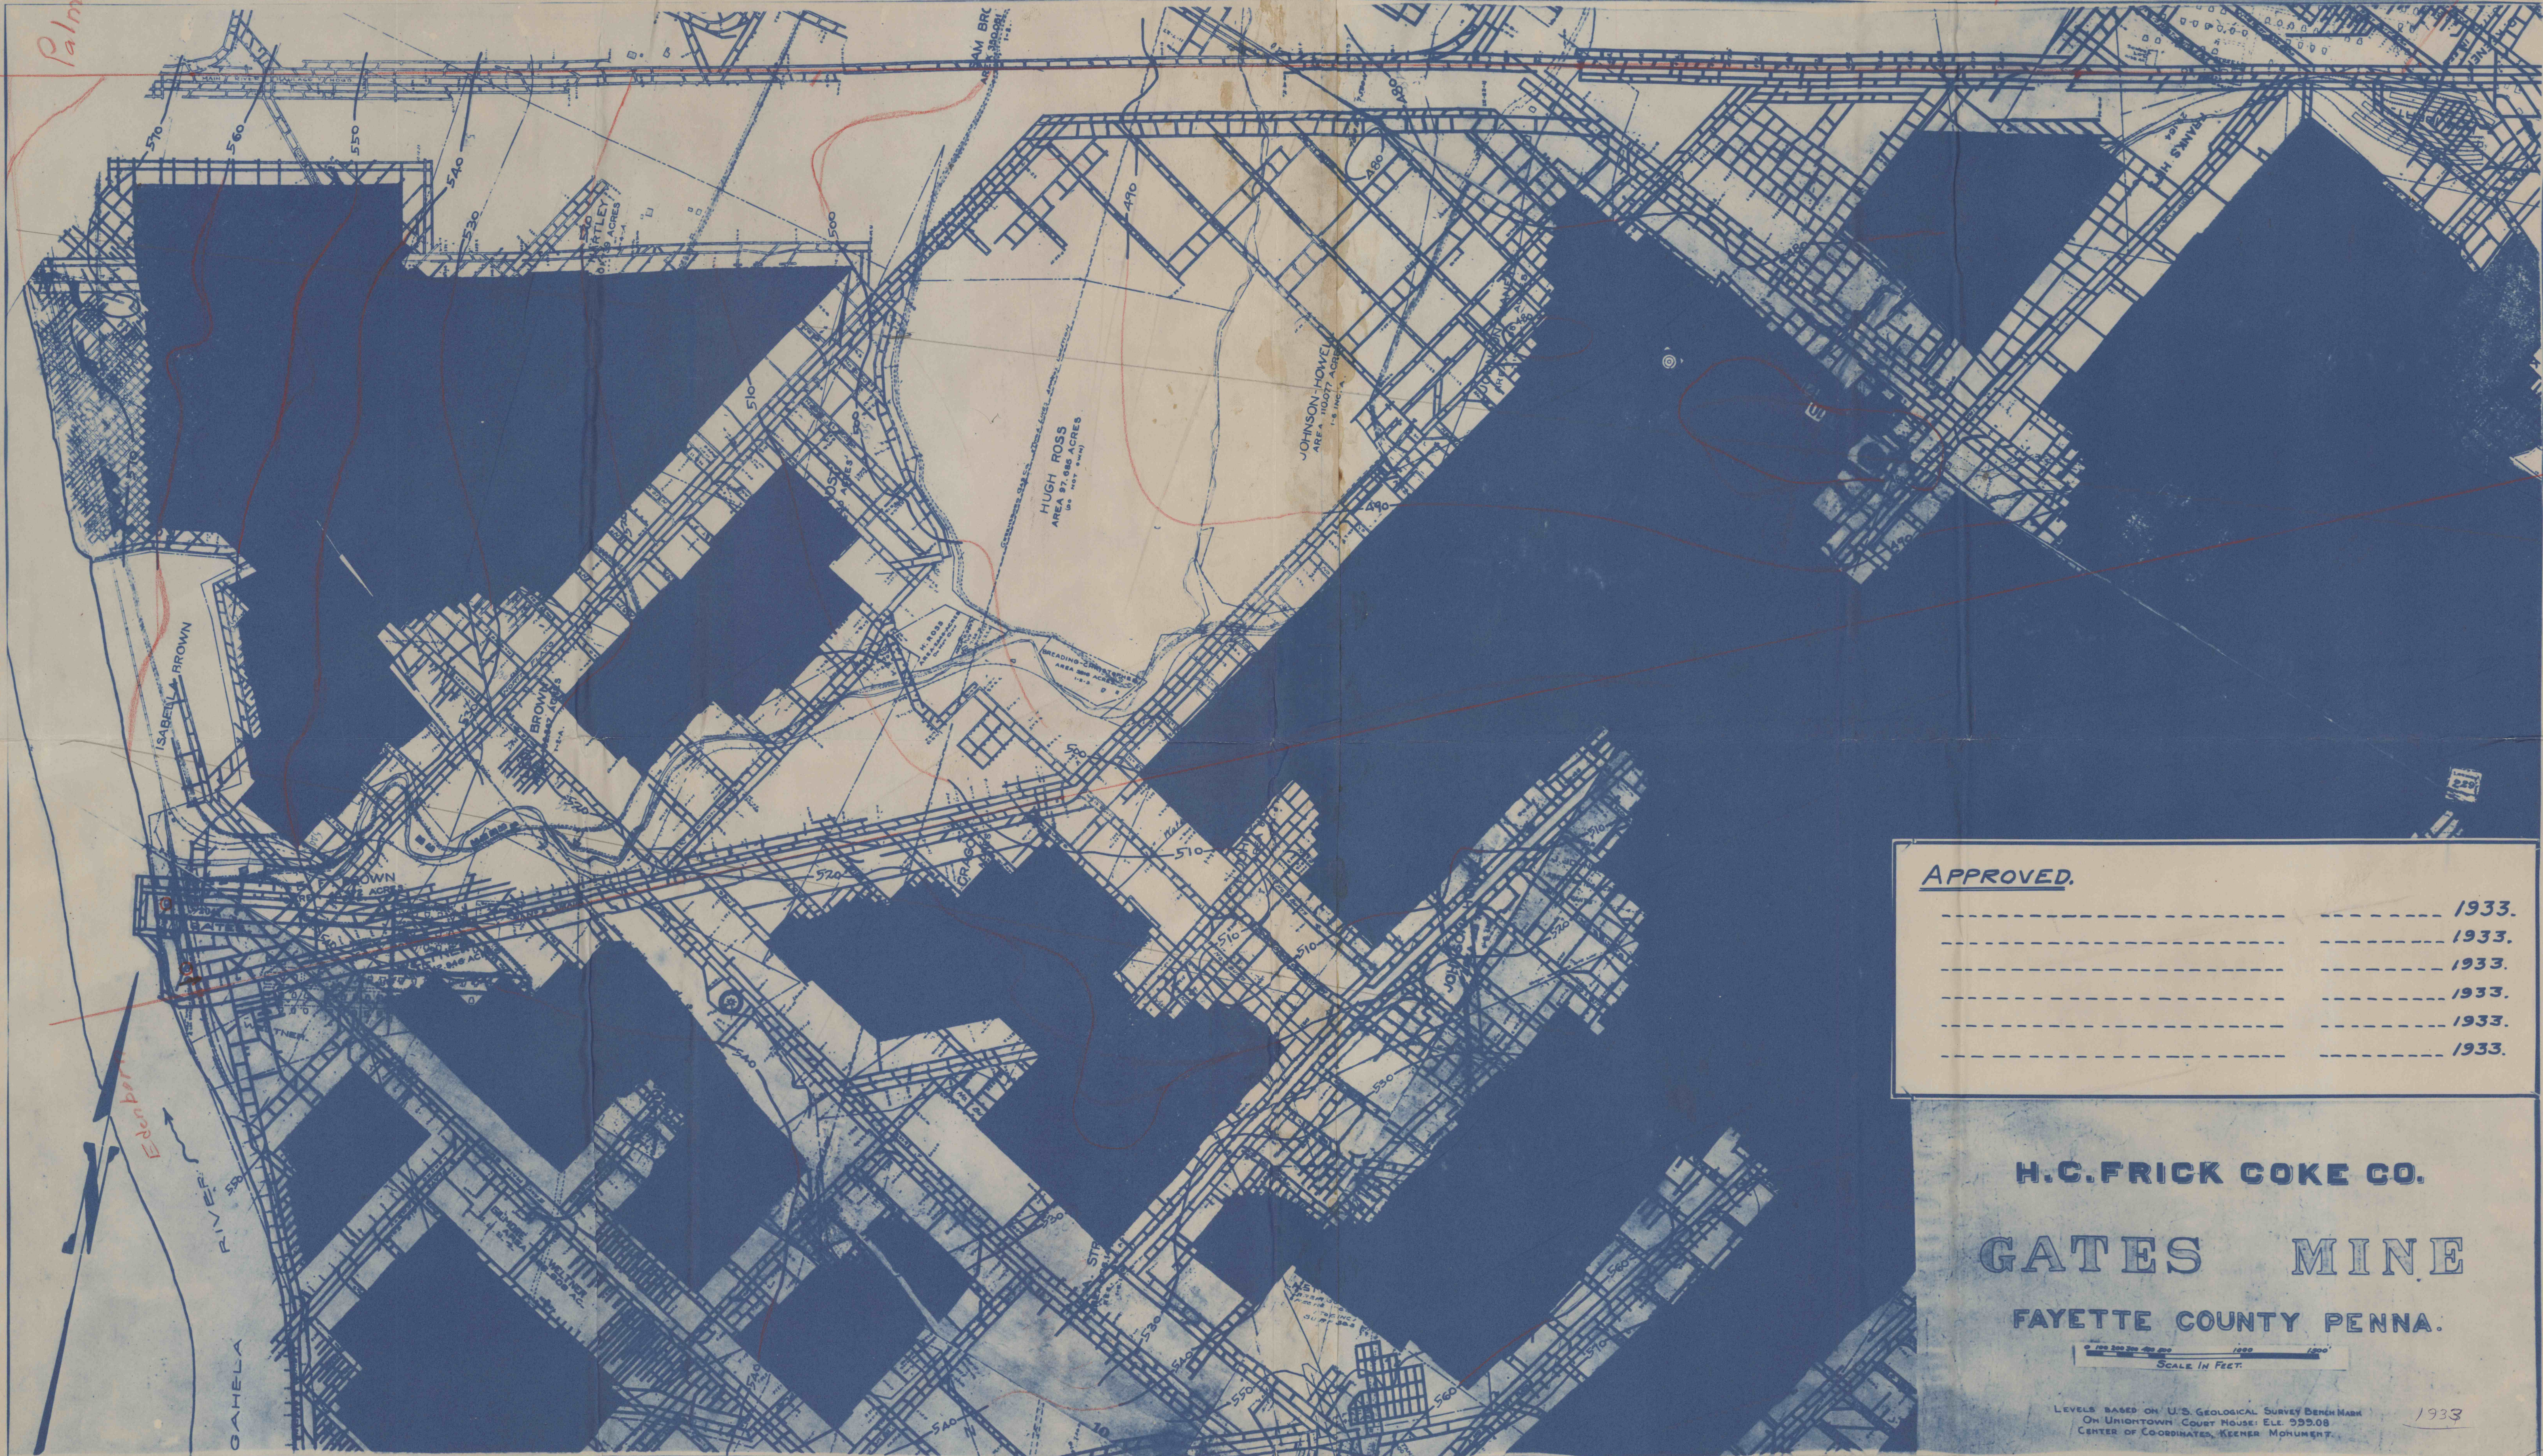


APPROVED.

- 1933.
- 1933.
- 1933.
- 1933.
- 1933.
- 1933.

H.C. FRICK COKE CO.

GATES MINE

FAYETTE COUNTY PENNA.

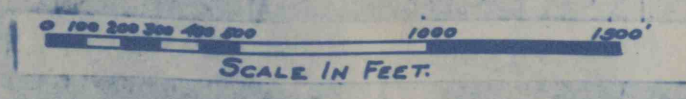

LEVELS BASED ON U.S. GEOLOGICAL SURVEY BENCH MARK
 ON UNIONTOWN COURT HOUSE: ELE. 995.08
 CENTER OF CO-ORDINATES, KEENER MONUMENT.

1933

#1084
7-22-99
CC