


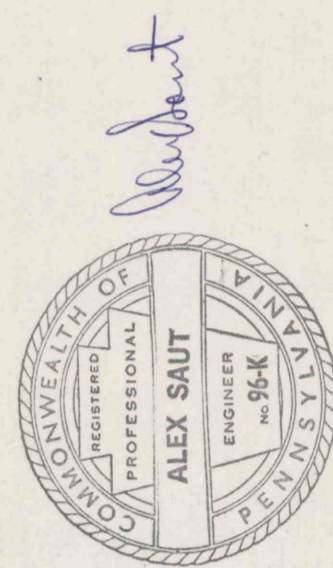

HUTCHINSON MINE
 SCALE 1"=500'
 SURVEY DATE 4-27-73
 (F.V.A.C.)



MAGEE MINE

Y.&O. COAL CO.