


*EXHIBIT "B"*  
**HUTCHINSON MINE**

SURVEY DATE 12-31-58

SCALE 1" = 500'

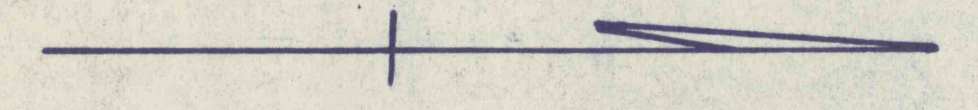

#1343  
5-99