


2 500' = 1"

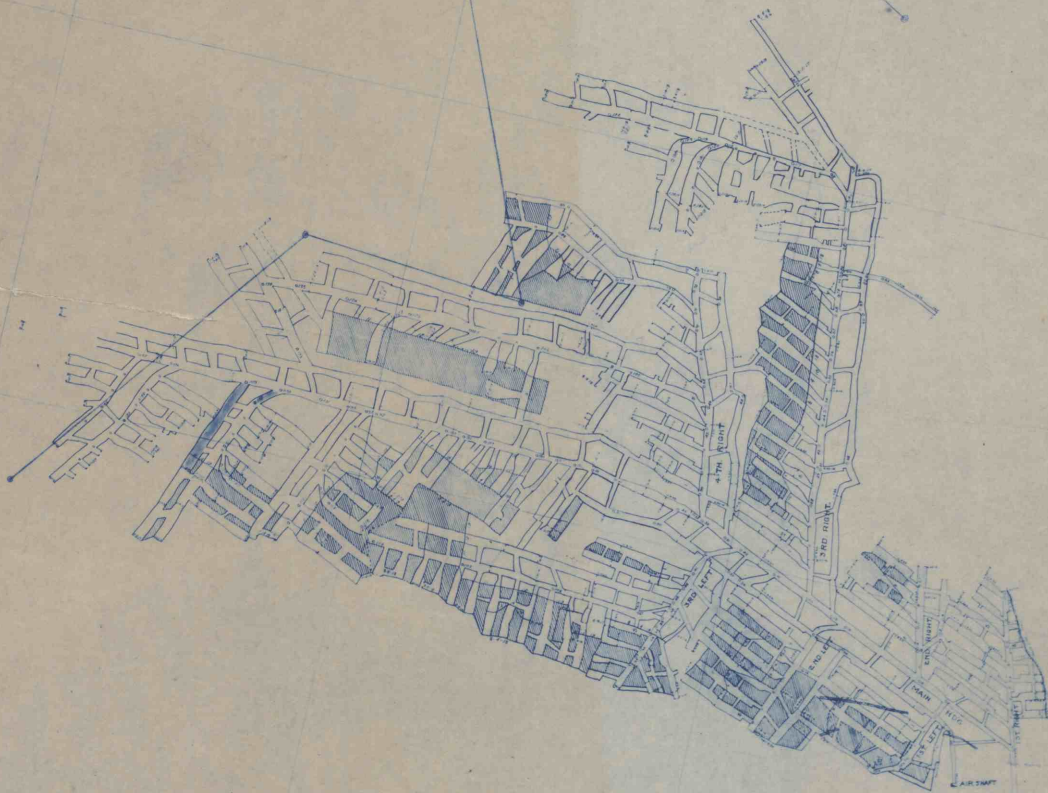

— MAP OF —
THE LANDSTREET MINE
WILBUR COAL MINING CO.
KNICKERBOCKER No 5

SCALE: 1" = 500'
DECEMBER - 1919

Somerset County

"B" Seam
Coal 3'-2"

CONSOL. No. 116

DEC 31 1919