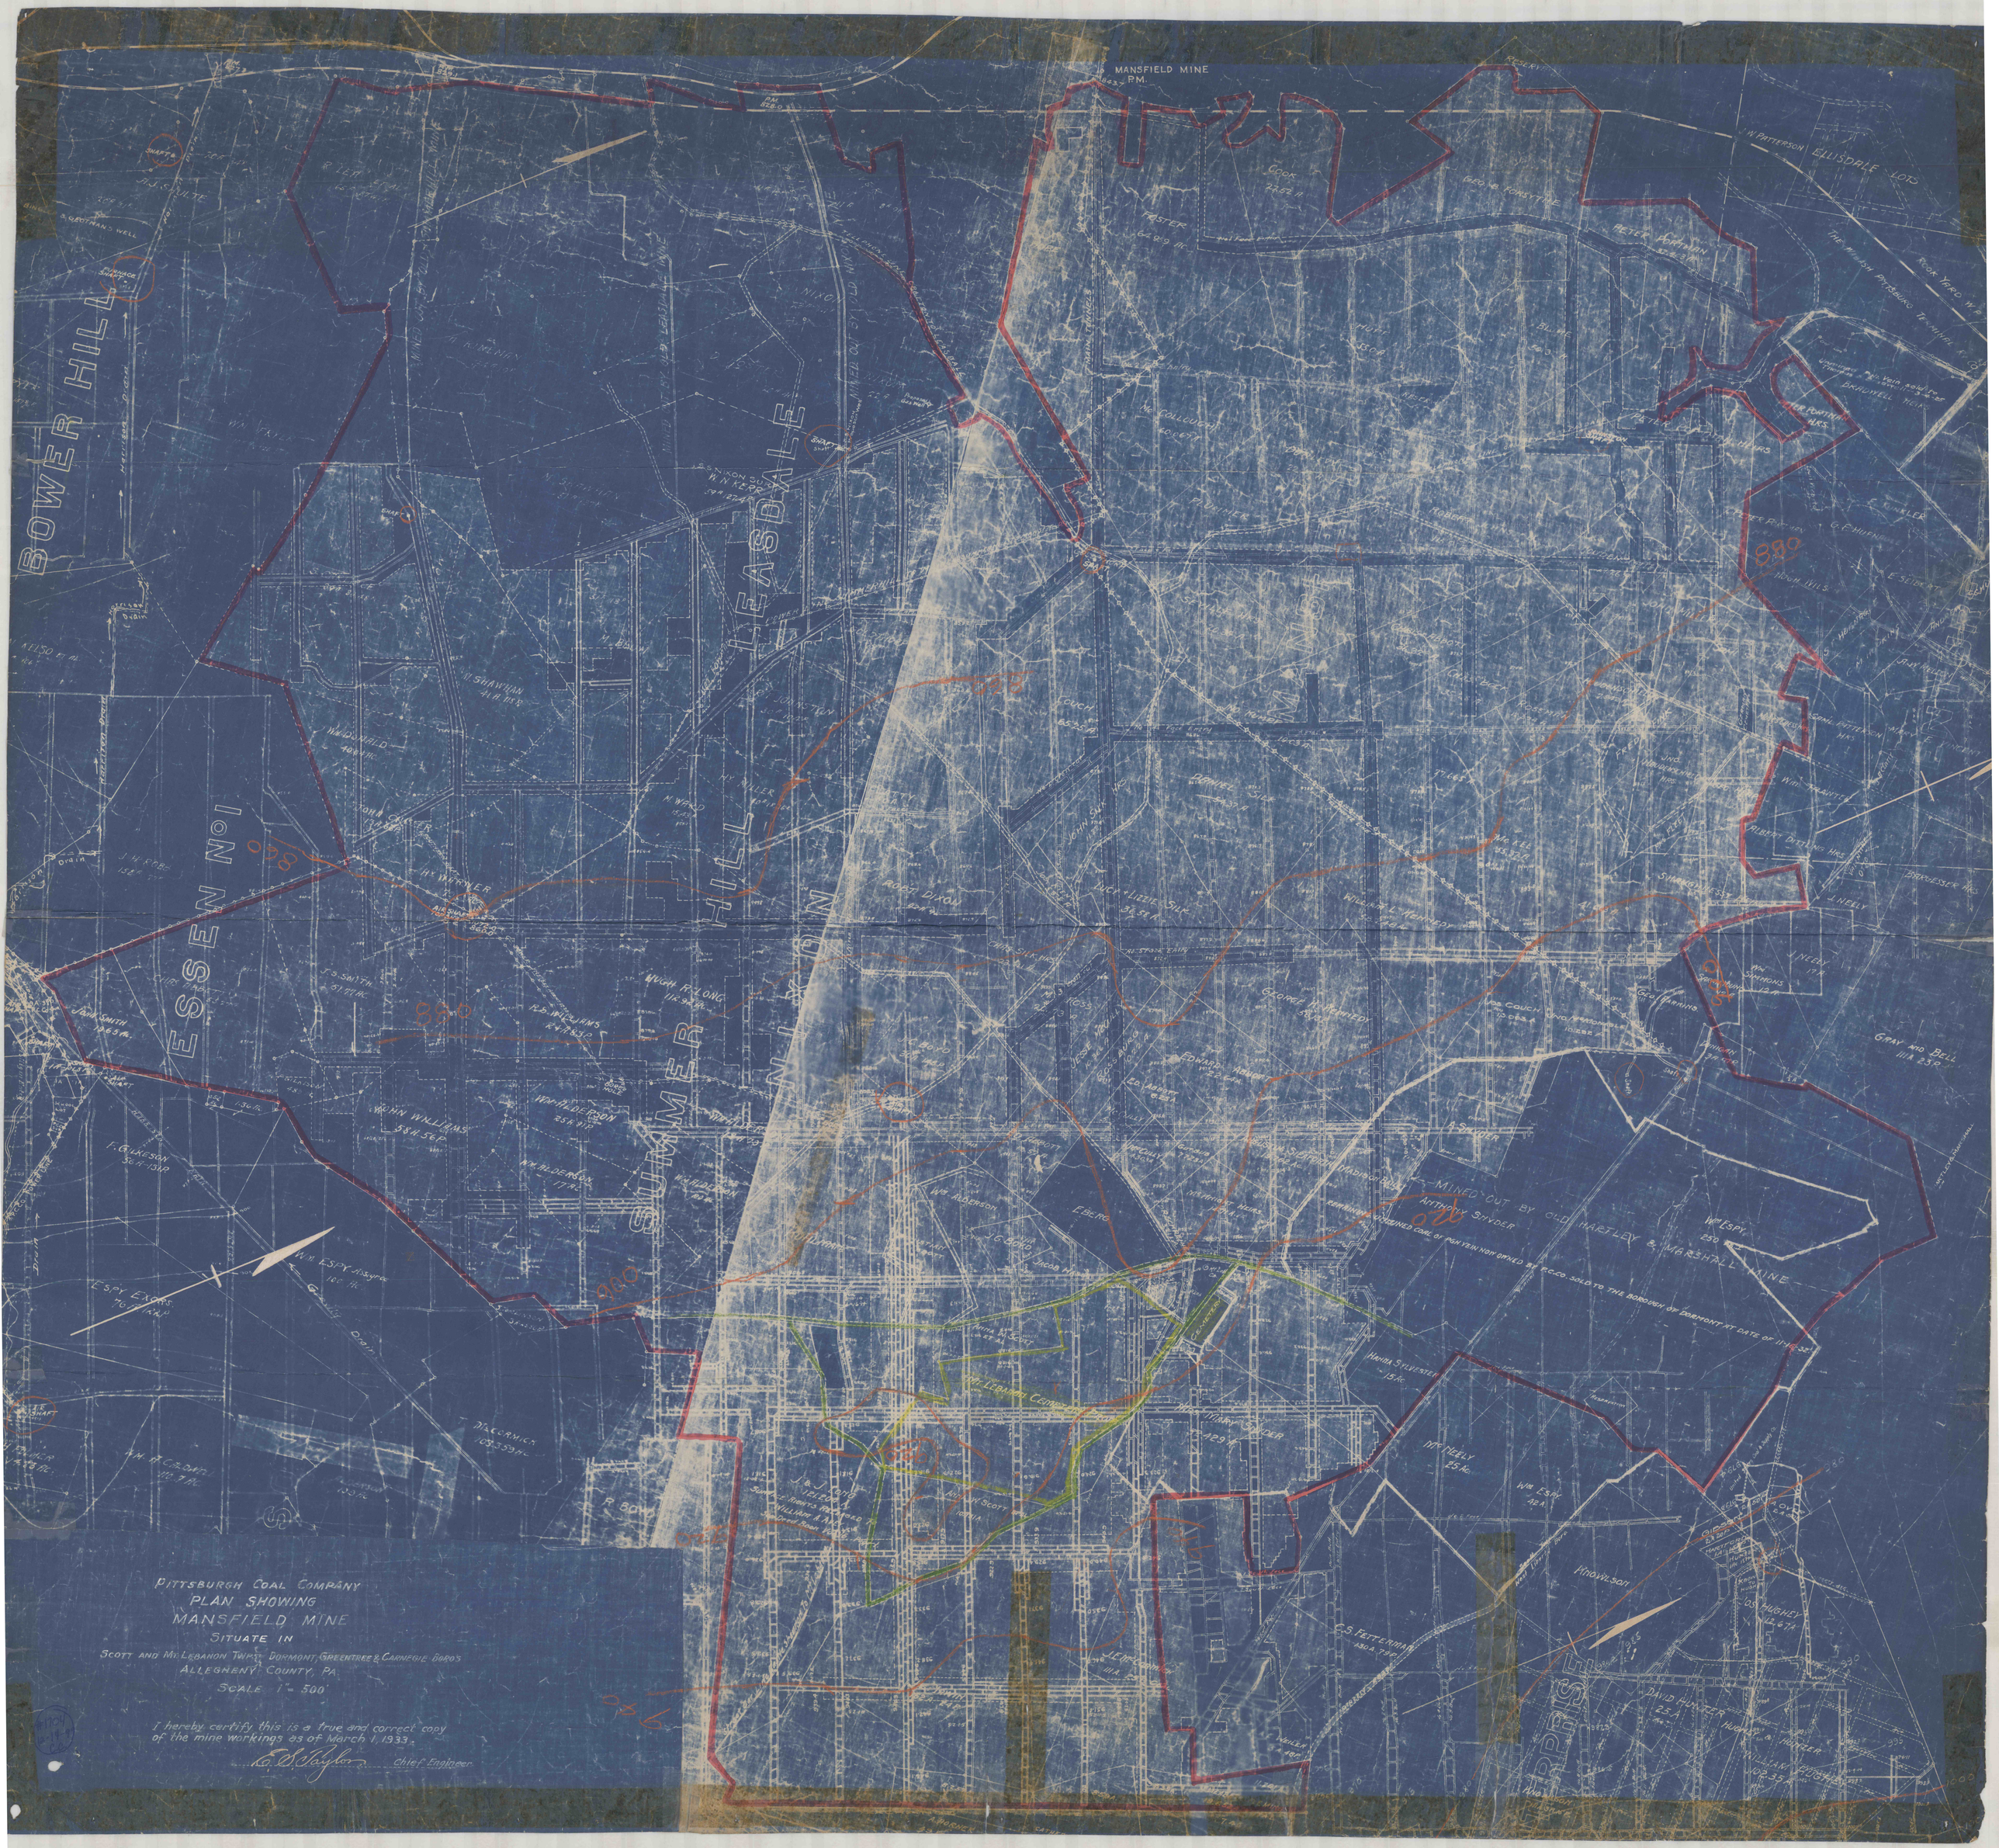
MANSFIELD MINE
P.M.
BOWER HILL
ESSEN No 1
SUMMER HILL
LEASDALE
ELLISDALE LOTS
MINED OUT BY OLD HARTLEY & MARSHALL MINE
PITTSBURGH COAL COMPANY
PLAN SHOWING
MANSFIELD MINE
SITUATE IN
SCOTT AND MT. LEBANON TWPS. DORMONT, GREENTREE & CARNEGIE BOROS
ALLEGHENY COUNTY, PA.
SCALE 1" = 500'
I hereby certify this is a true and correct copy
of the mine workings as of March 1, 1933.
E. S. Taylor
Chief Engineer