


MOON RUN

PITTSBURGH COAL COMPANY
 PLAN SHOWING
MOON RUN MINE
 SITUATE IN
 COLLIER, KENNEDY, NORTH FAYETTE, ROBINSON TOWNSHIPS
 ALLEGHENY COUNTY, PA.

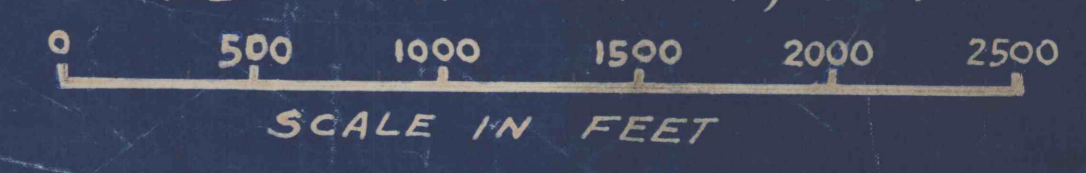

I HEREBY CERTIFY THIS IS A TRUE AND CORRECT COPY OF
 THE MINE WORKINGS AS OF MARCH 31, 1939.
F.S. Hall
 CHIEF ENGINEER