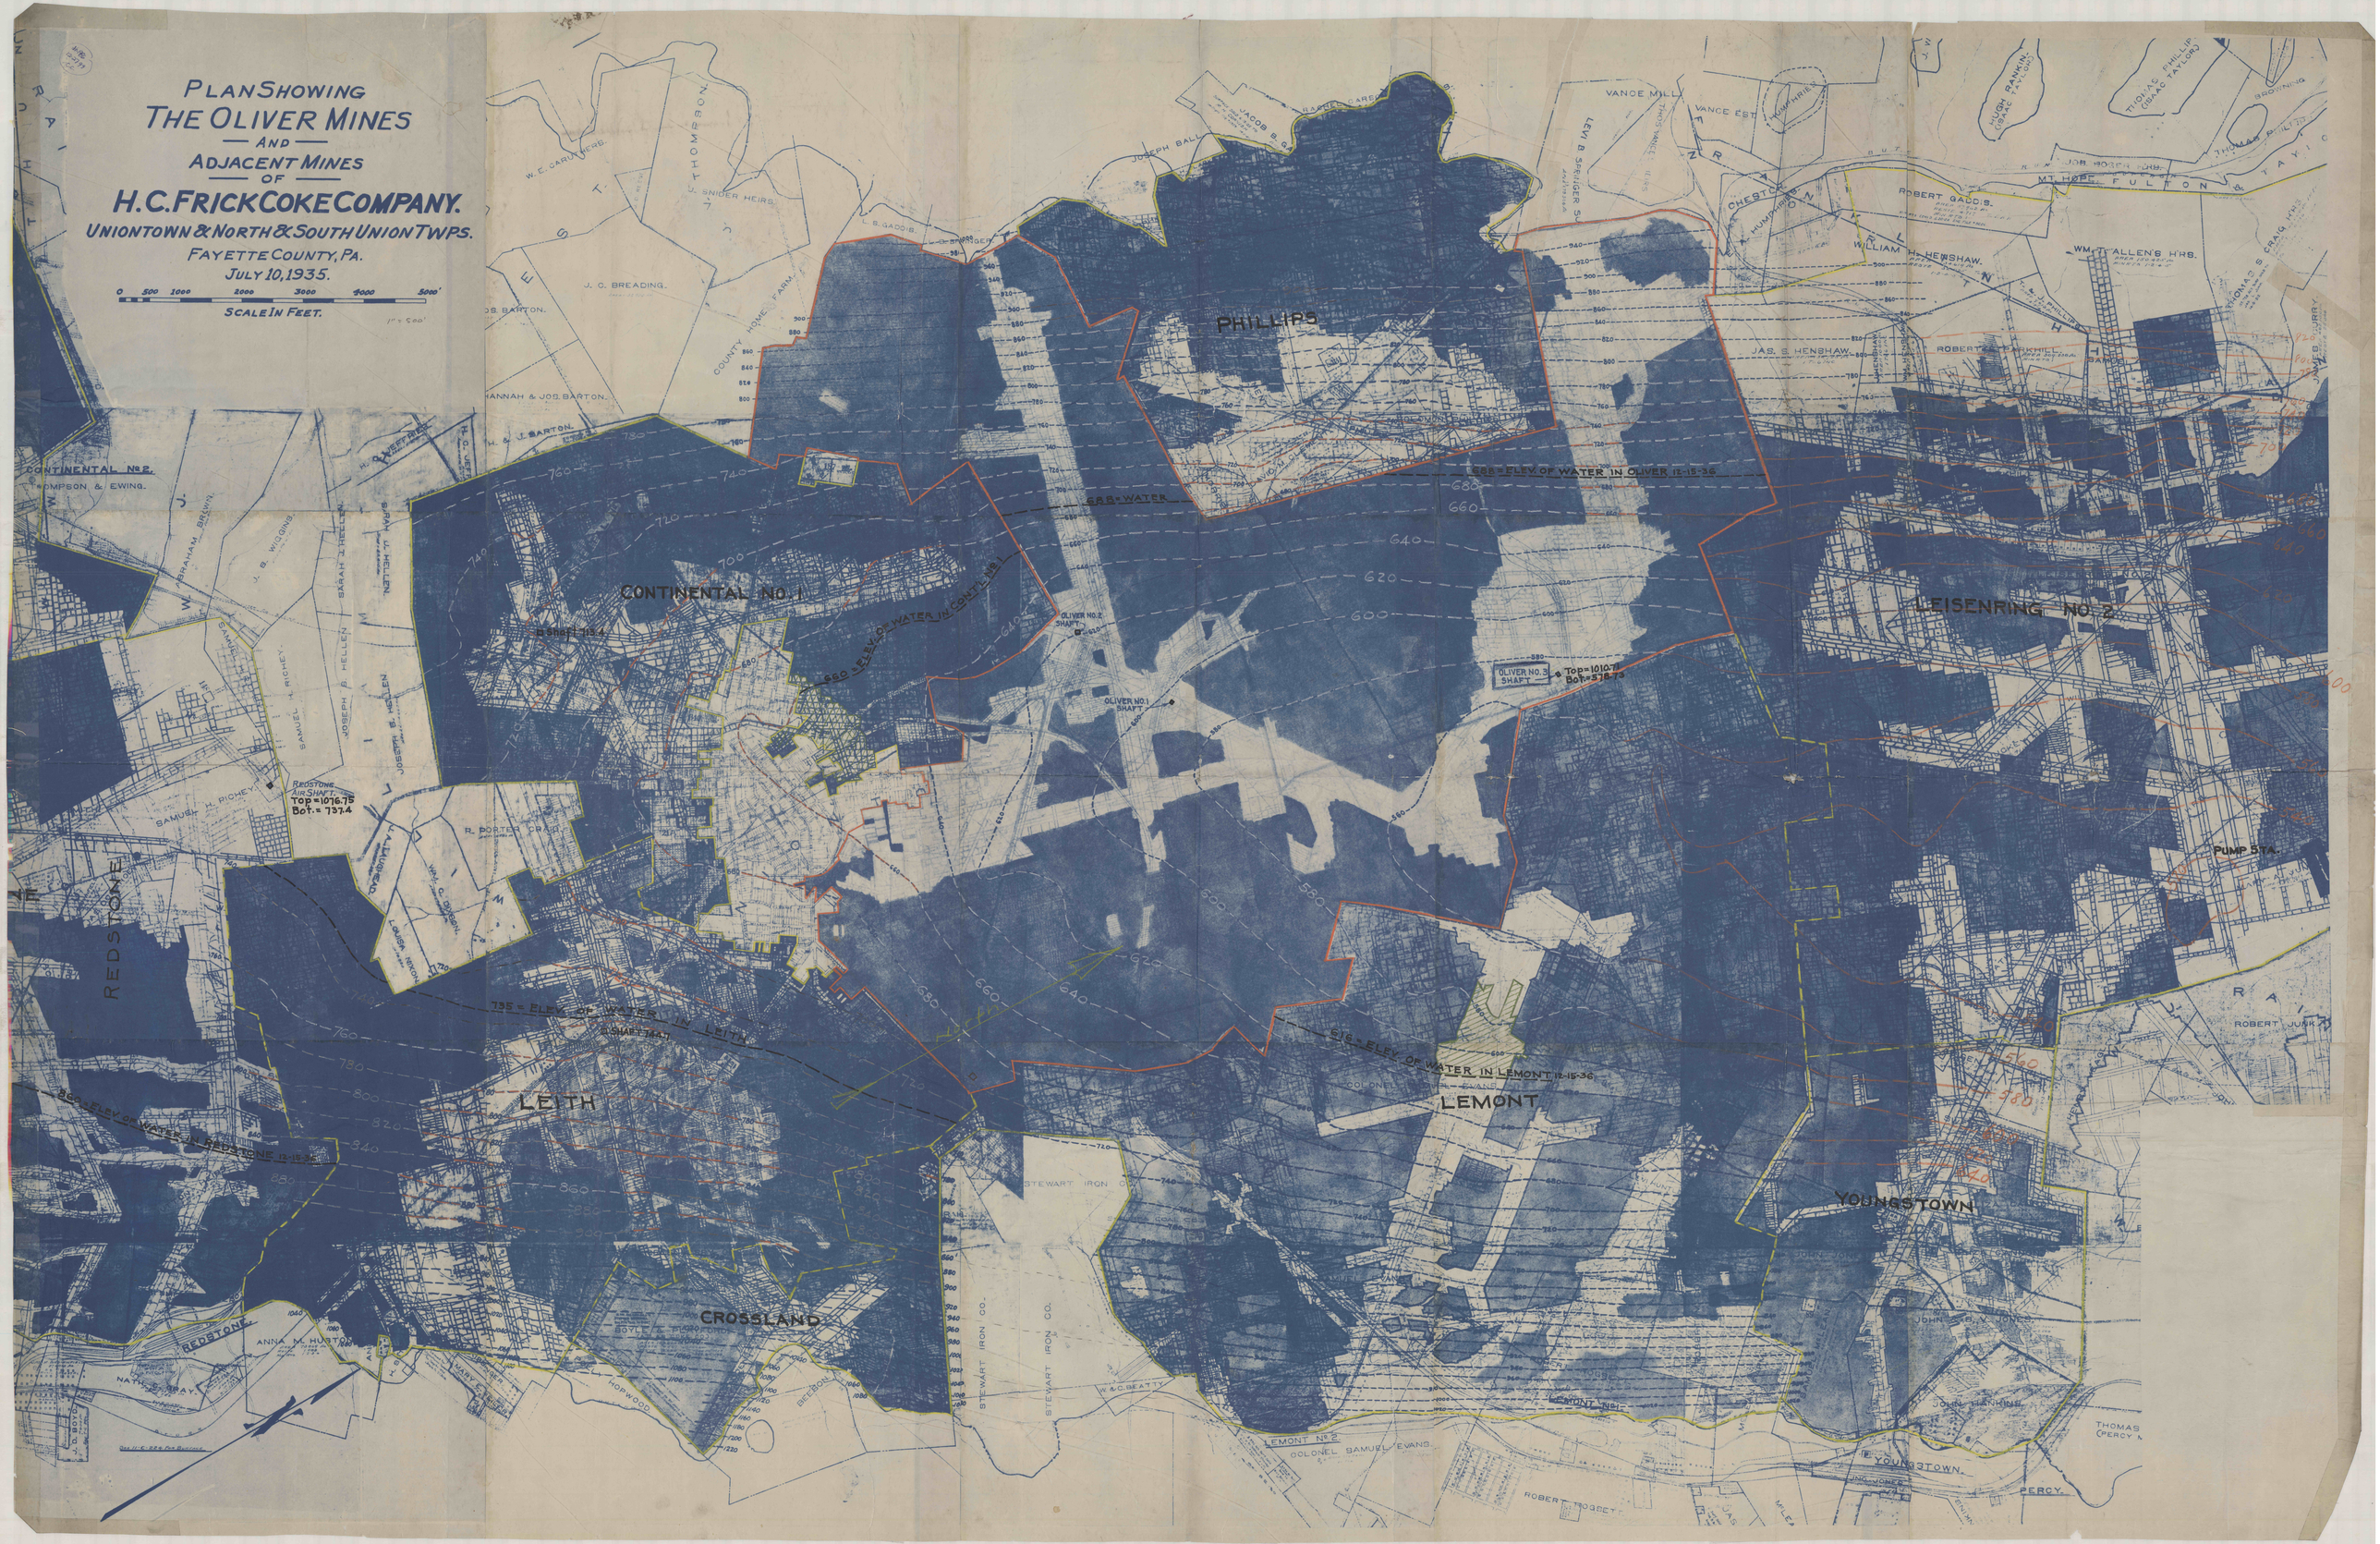
PLAN SHOWING
THE OLIVER MINES
AND
ADJACENT MINES
OF
H.C. FRICK COKE COMPANY.
UNIONTOWN & NORTH & SOUTH UNION TWPS.
FAYETTE COUNTY, PA.
JULY 10, 1935.
0 500 1000 2000 3000 4000 5000'
SCALE IN FEET.
1" = 500'
PHILLIPS
CONTINENTAL NO. 1
LEISENRING NO. 2
REDSTONE
LEITH
CROSSLAND
LEMONT
YOUNGSTOWN
688 = ELEV. OF WATER IN OLIVER 12-15-36
688 = WATER
690 = ELEV. OF WATER IN CONTL. NO. 1
735 = ELEV. OF WATER IN LEITH
820 = ELEV. OF WATER IN REDSTONE 12-15-36
816 = ELEV. OF WATER IN LEMONT 12-15-36
OLIVER NO. 1 SHAFT
OLIVER NO. 2 SHAFT
OLIVER NO. 3 SHAFT
Top = 1010.71
Bot. = 578.73
REDSTONE AIR SHAFT
Top = 1016.75
Bot. = 737.4
PUMP STA.
CONTINENTAL Nº 2
THOMPSON & EWING
W. C. CARUTHERS
J. SNIDER HEIRS
J. C. BREADING
COUNTY HOME FARM
HANNAH & JOS. BARTON
JOSEPH BALL
VANCE MILL
VANCE EST.
HUMPHRIES
ROBERT GADDIS
WILLIAM H. HENSHAW
WM. T. ALLEN'S HRS.
JAS. S. HENSHAW
ROBERT E. POWELL
SAMUEL H. RICHEY
R. PORTER CRAIG
ANNA M. HUSTON
NATH. MAY
STEWART IRON CO.
W. & C. BEATTY
LEMONT Nº 2
COLONEL SAMUEL EVANS
ROBERT HOBBET
JOHN HANKINS
THOMAS PERCY
ROBERT JUSKA
YOUNGSTOWN
PERCY