


# RALPH MINE


H.C. FRICK COKE CO.

FAYETTE COUNTY PA.

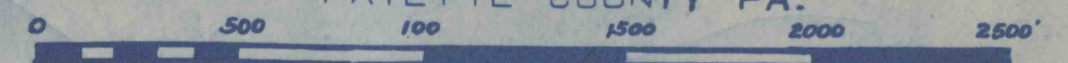

SCALE IN FEET  
DATUM - LEVEL  
U.S. GEOLOGICAL SURVEY

DATE OF LAST SURVEY

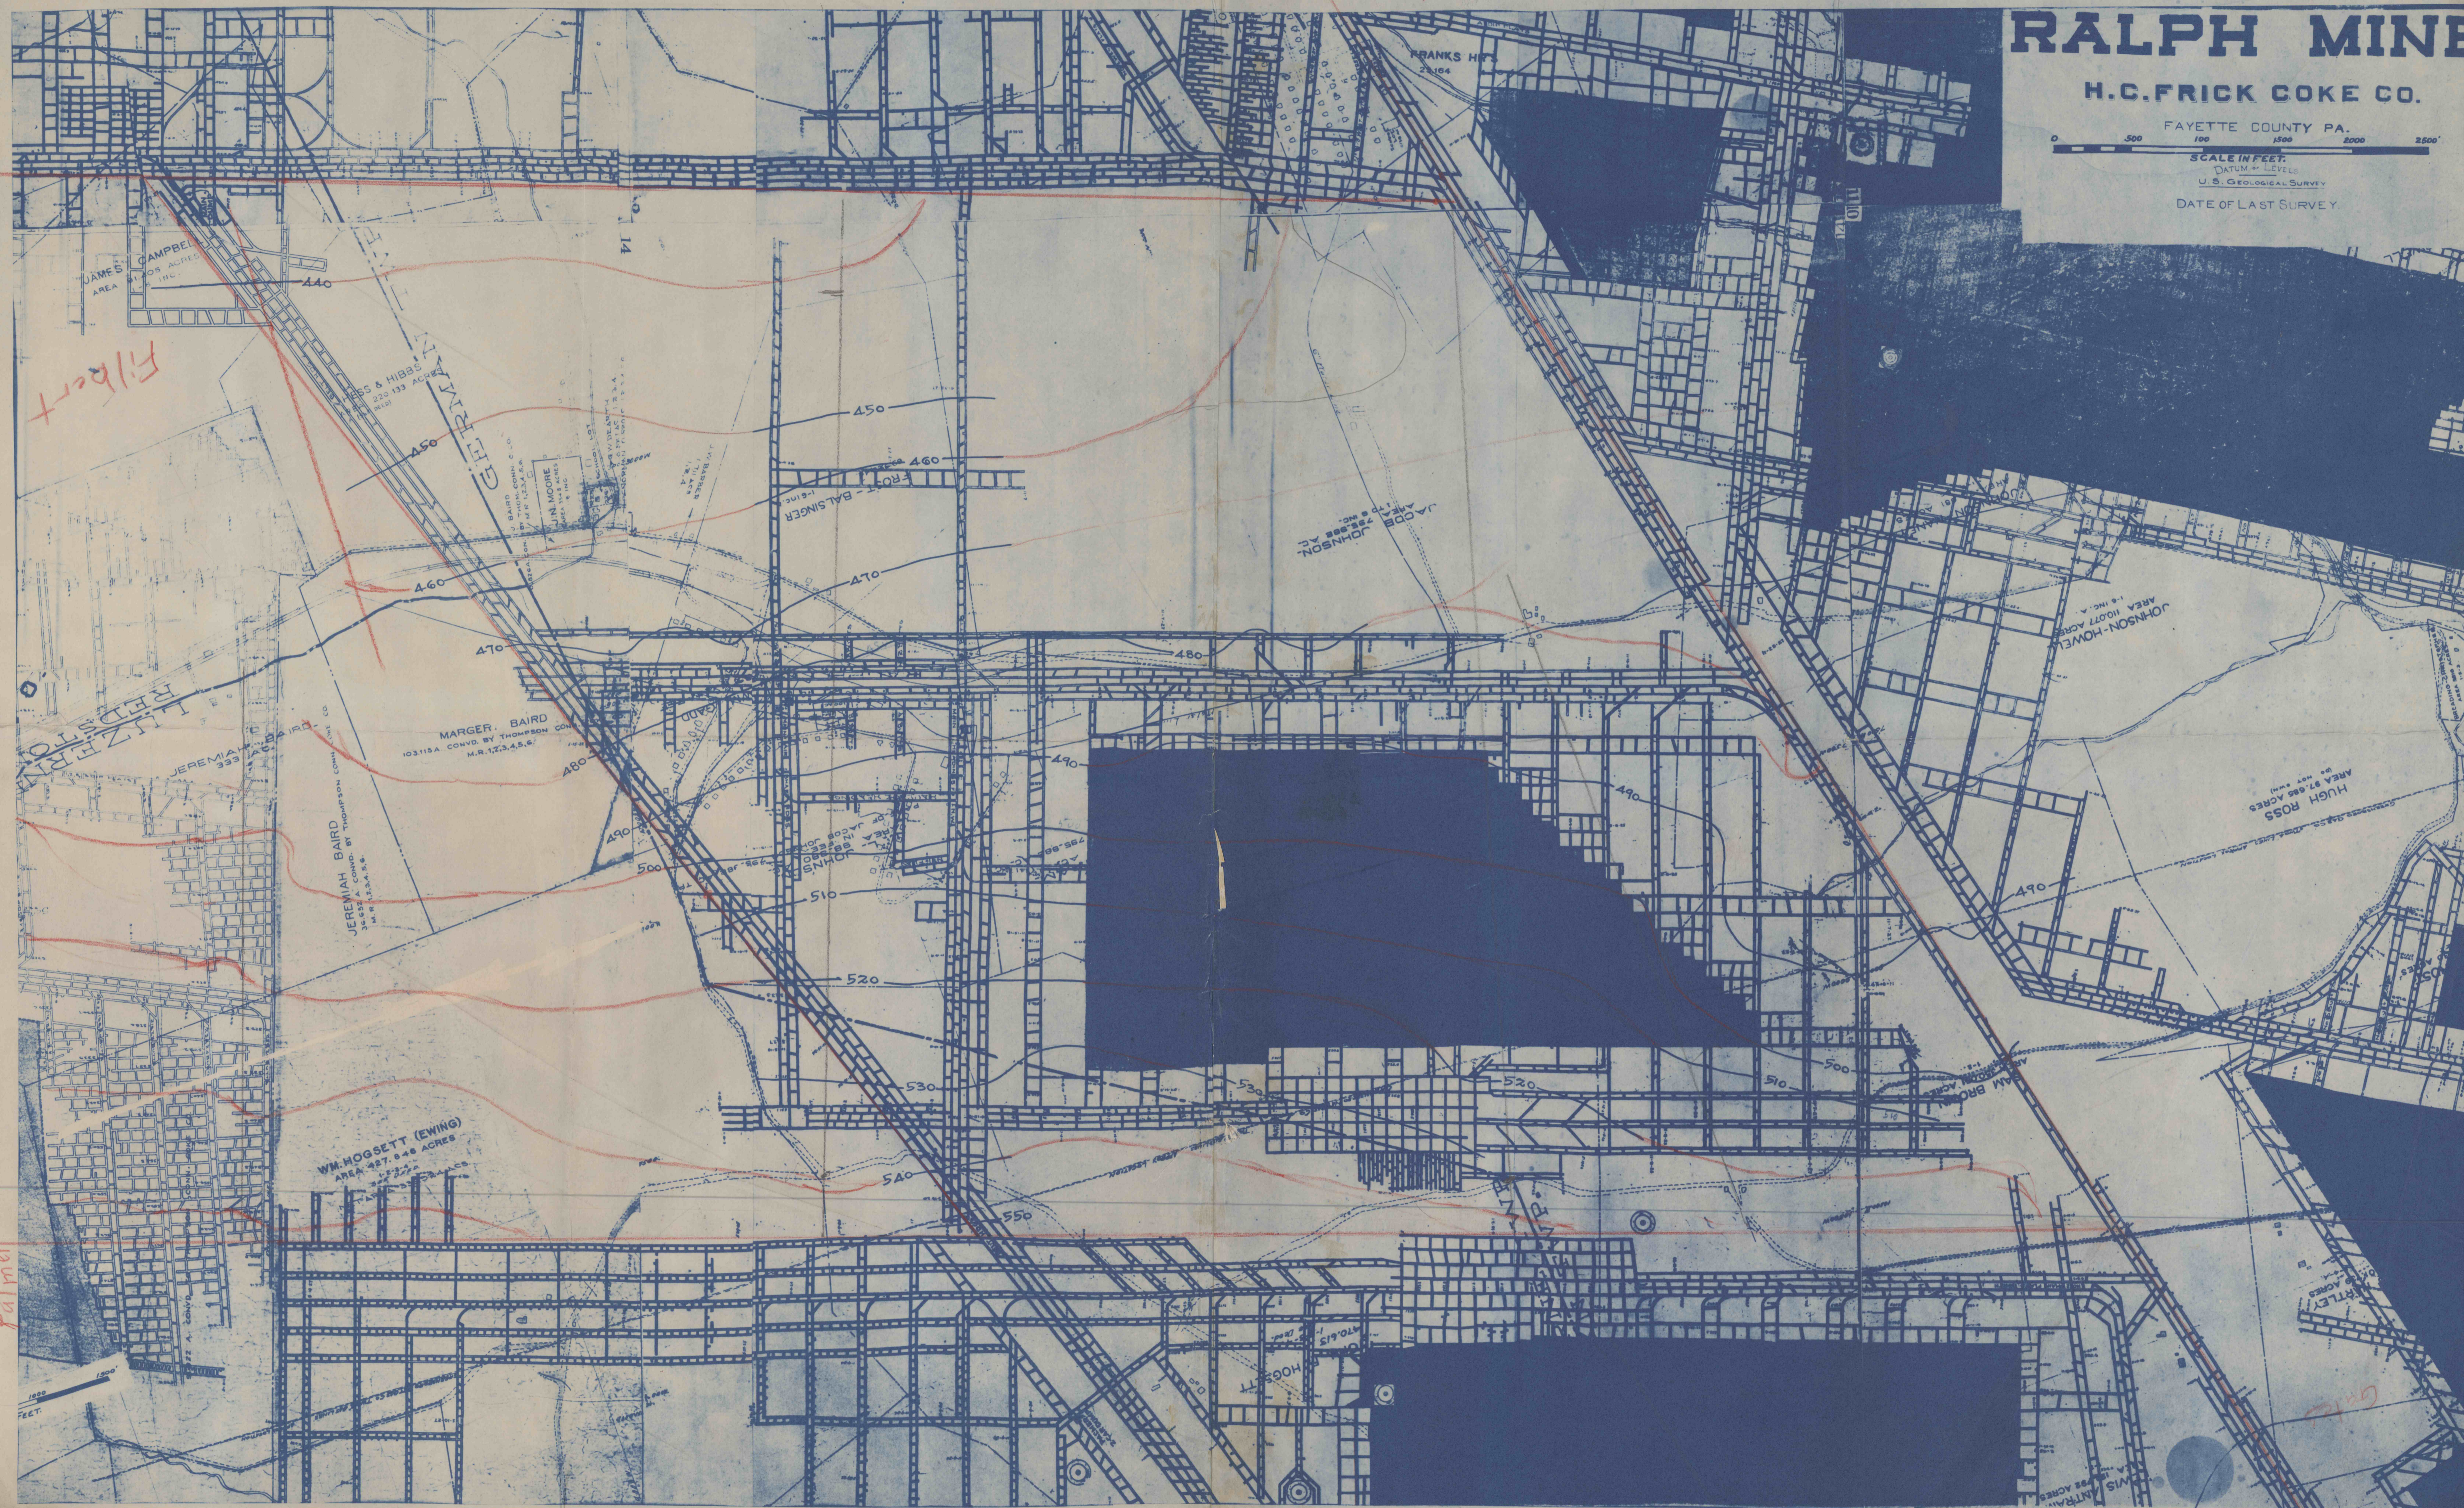

Lambert

Lambert Gates

Filbert

Palmer

64

CC