




ATTACHMENT A8-1A

RENTON MINE
1983
1"=500'

1982 WORKINGS
FAULTY AREAS
MAIN TRACK
ABD - ACTIVE WELLS
MG SETS - RECTIFIERS
RUMPS TO OUTSIDE
SURFACES OWNED
BELT

1983
JANUARY
FEBRUARY
MARCH
APRIL
MAY
JUNE
JULY
AUGUST
SEPTEMBER
OCTOBER
NOVEMBER
DECEMBER

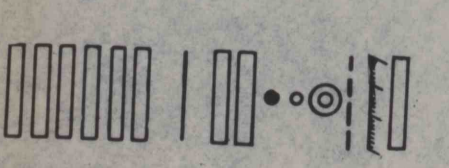

LEGEND

DRILL HOLES
● COAL INTERSECTED OF MINERABLE THICKNESS
○ COAL INTERSECTED BELOW MINERABLE THICKNESS
○ NO COAL INTERSECTED

CORE HOLES
● COAL INTERSECTED OF MINERABLE THICKNESS
○ COAL INTERSECTED BELOW MINERABLE THICKNESS
○ NO COAL INTERSECTED

10-25-83
10-25-83