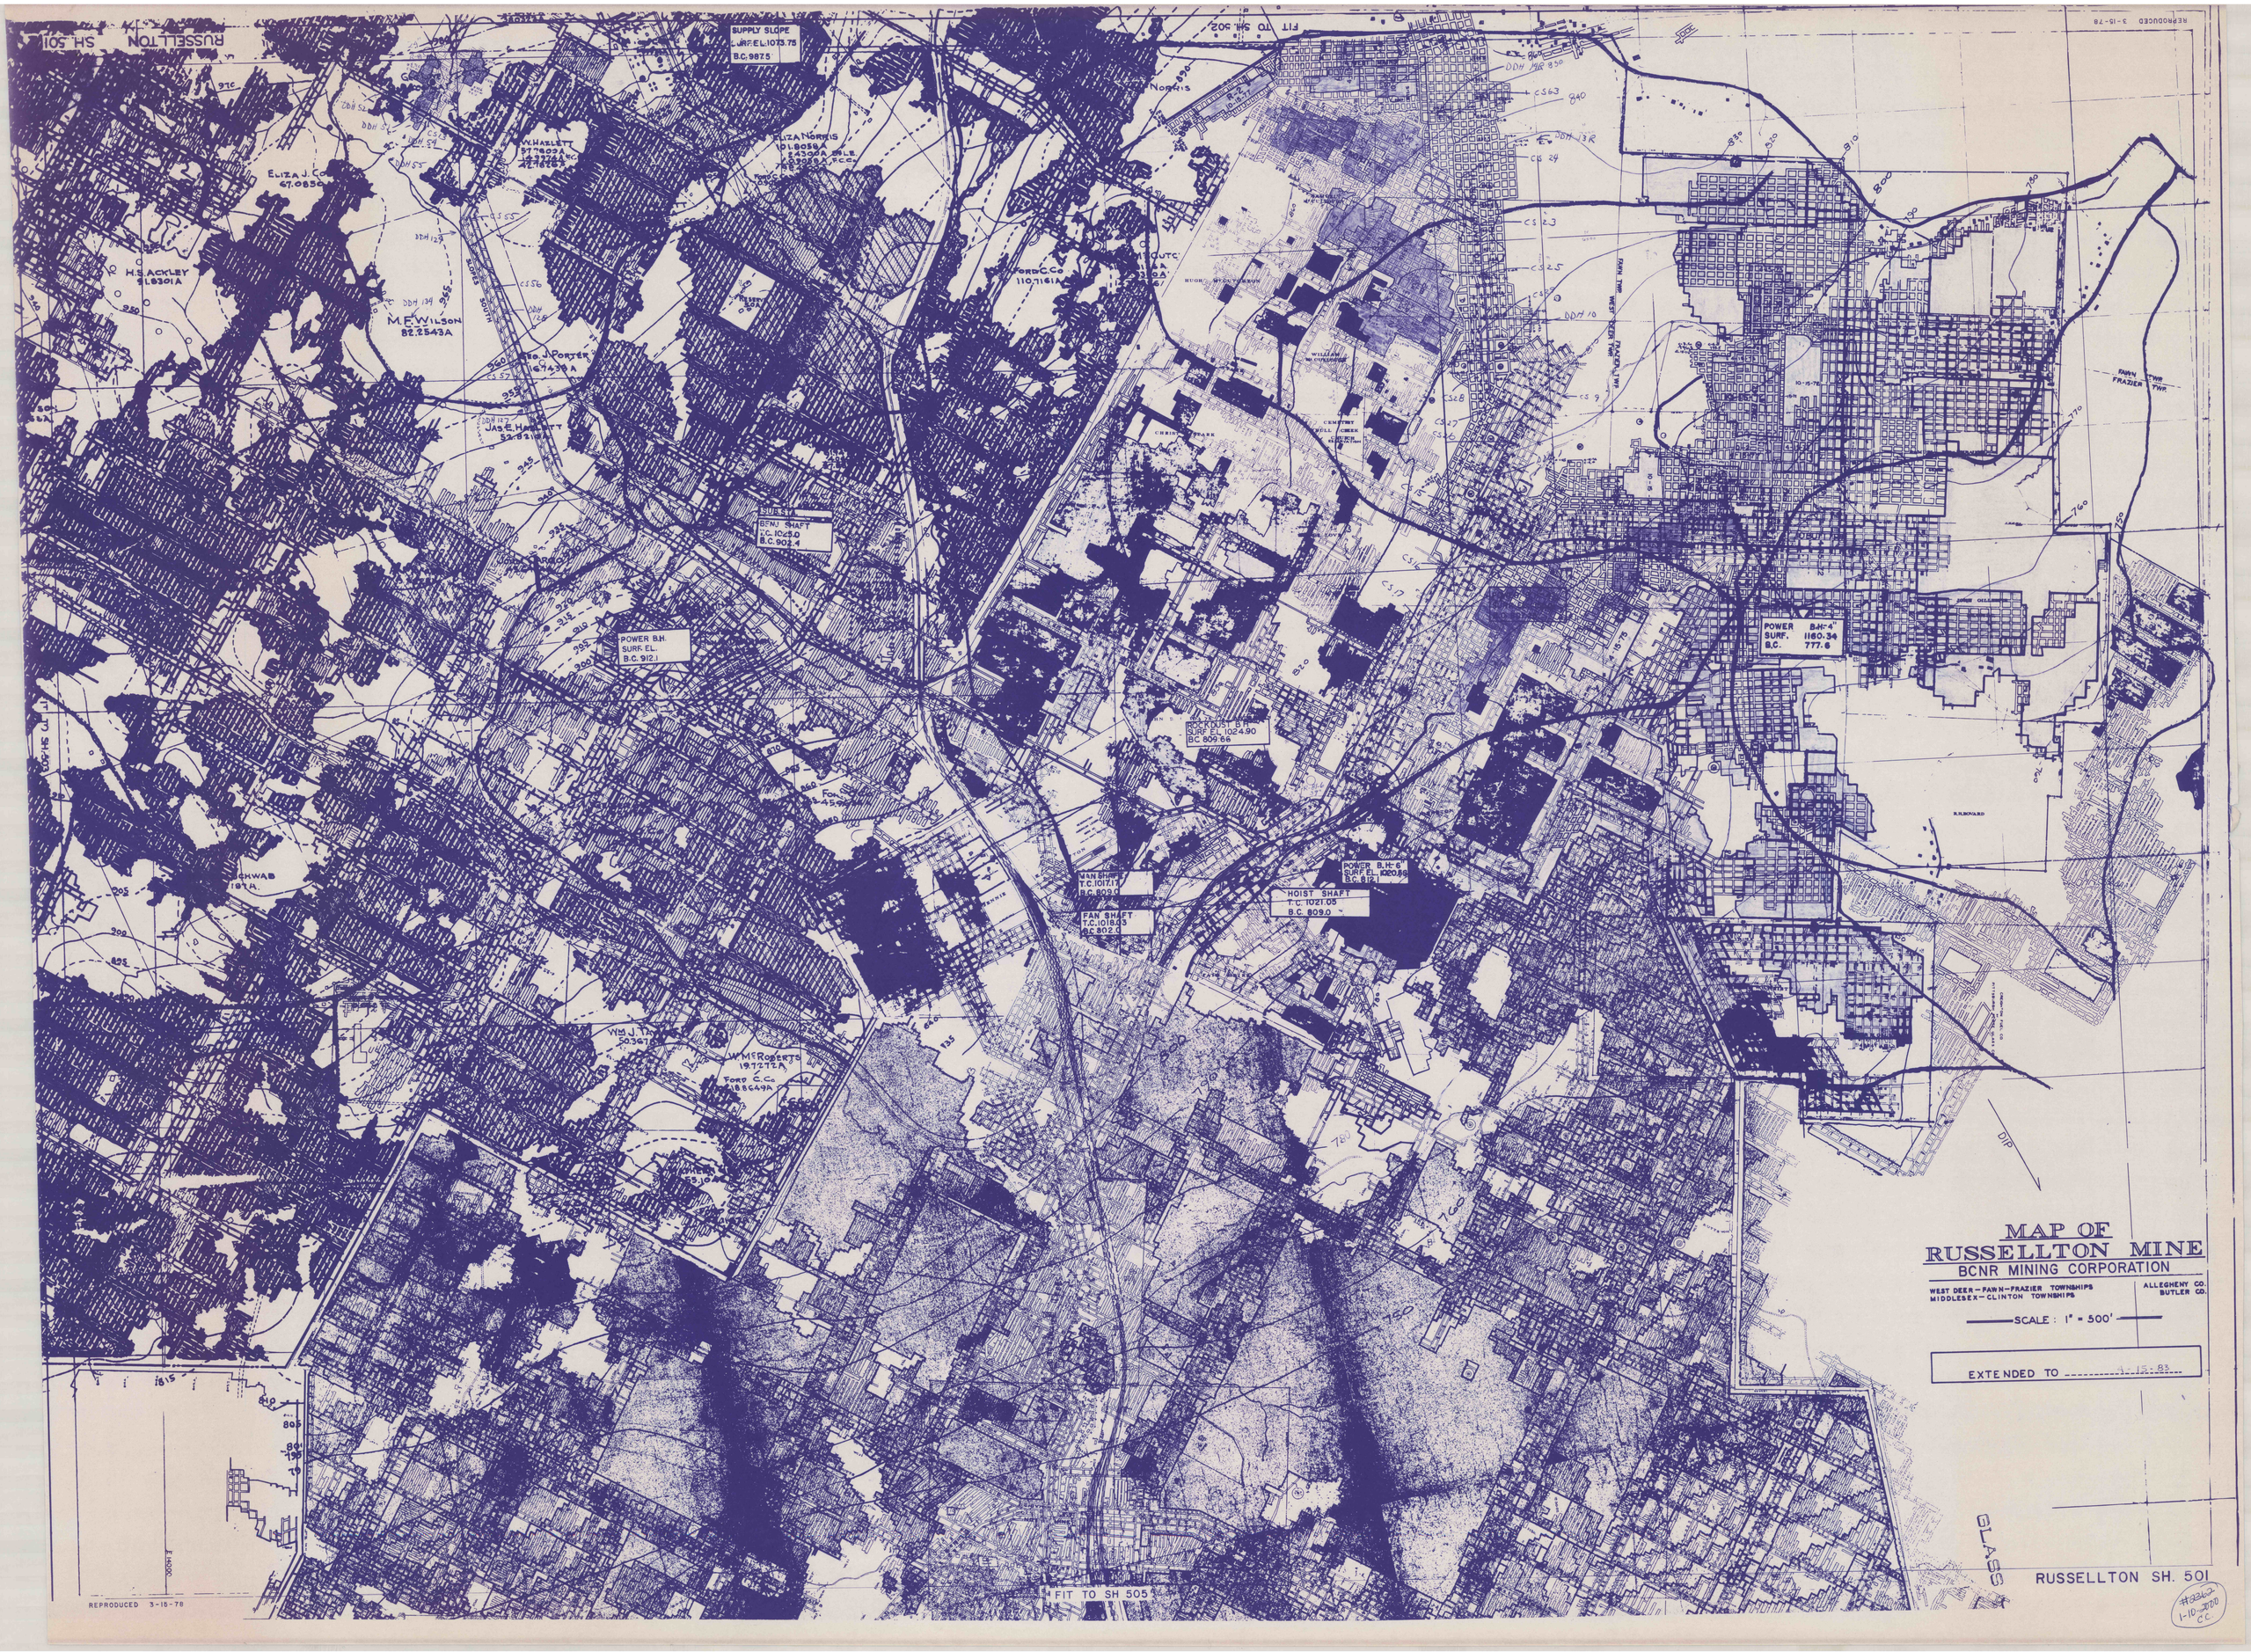

MAP OF RUSSELLTON MINE

BCNR MINING CORPORATION

WEST DEER – FAWN – FRAZIER TOWNSHIPS
MIDDLESEX – CLINTON TOWNSHIPS

ALLEGHENY CO.
BUTLER CO.

SCALE : 1" = 500'

EXTENDED TO 4-15-83

RUSSELLTON SH. 501

#2262
1-10-2000
C.C.