


BRIDGEPORT MINE

REPUBLIC CONNELLVILLE
COKE CO.

FAYETTE COUNTY PA
0 500 1000 1500 2000 2500 3000 3500

SCALE IN FEET.

DATE IN LEVEL
U.S. GEOLOGICAL SURVEY

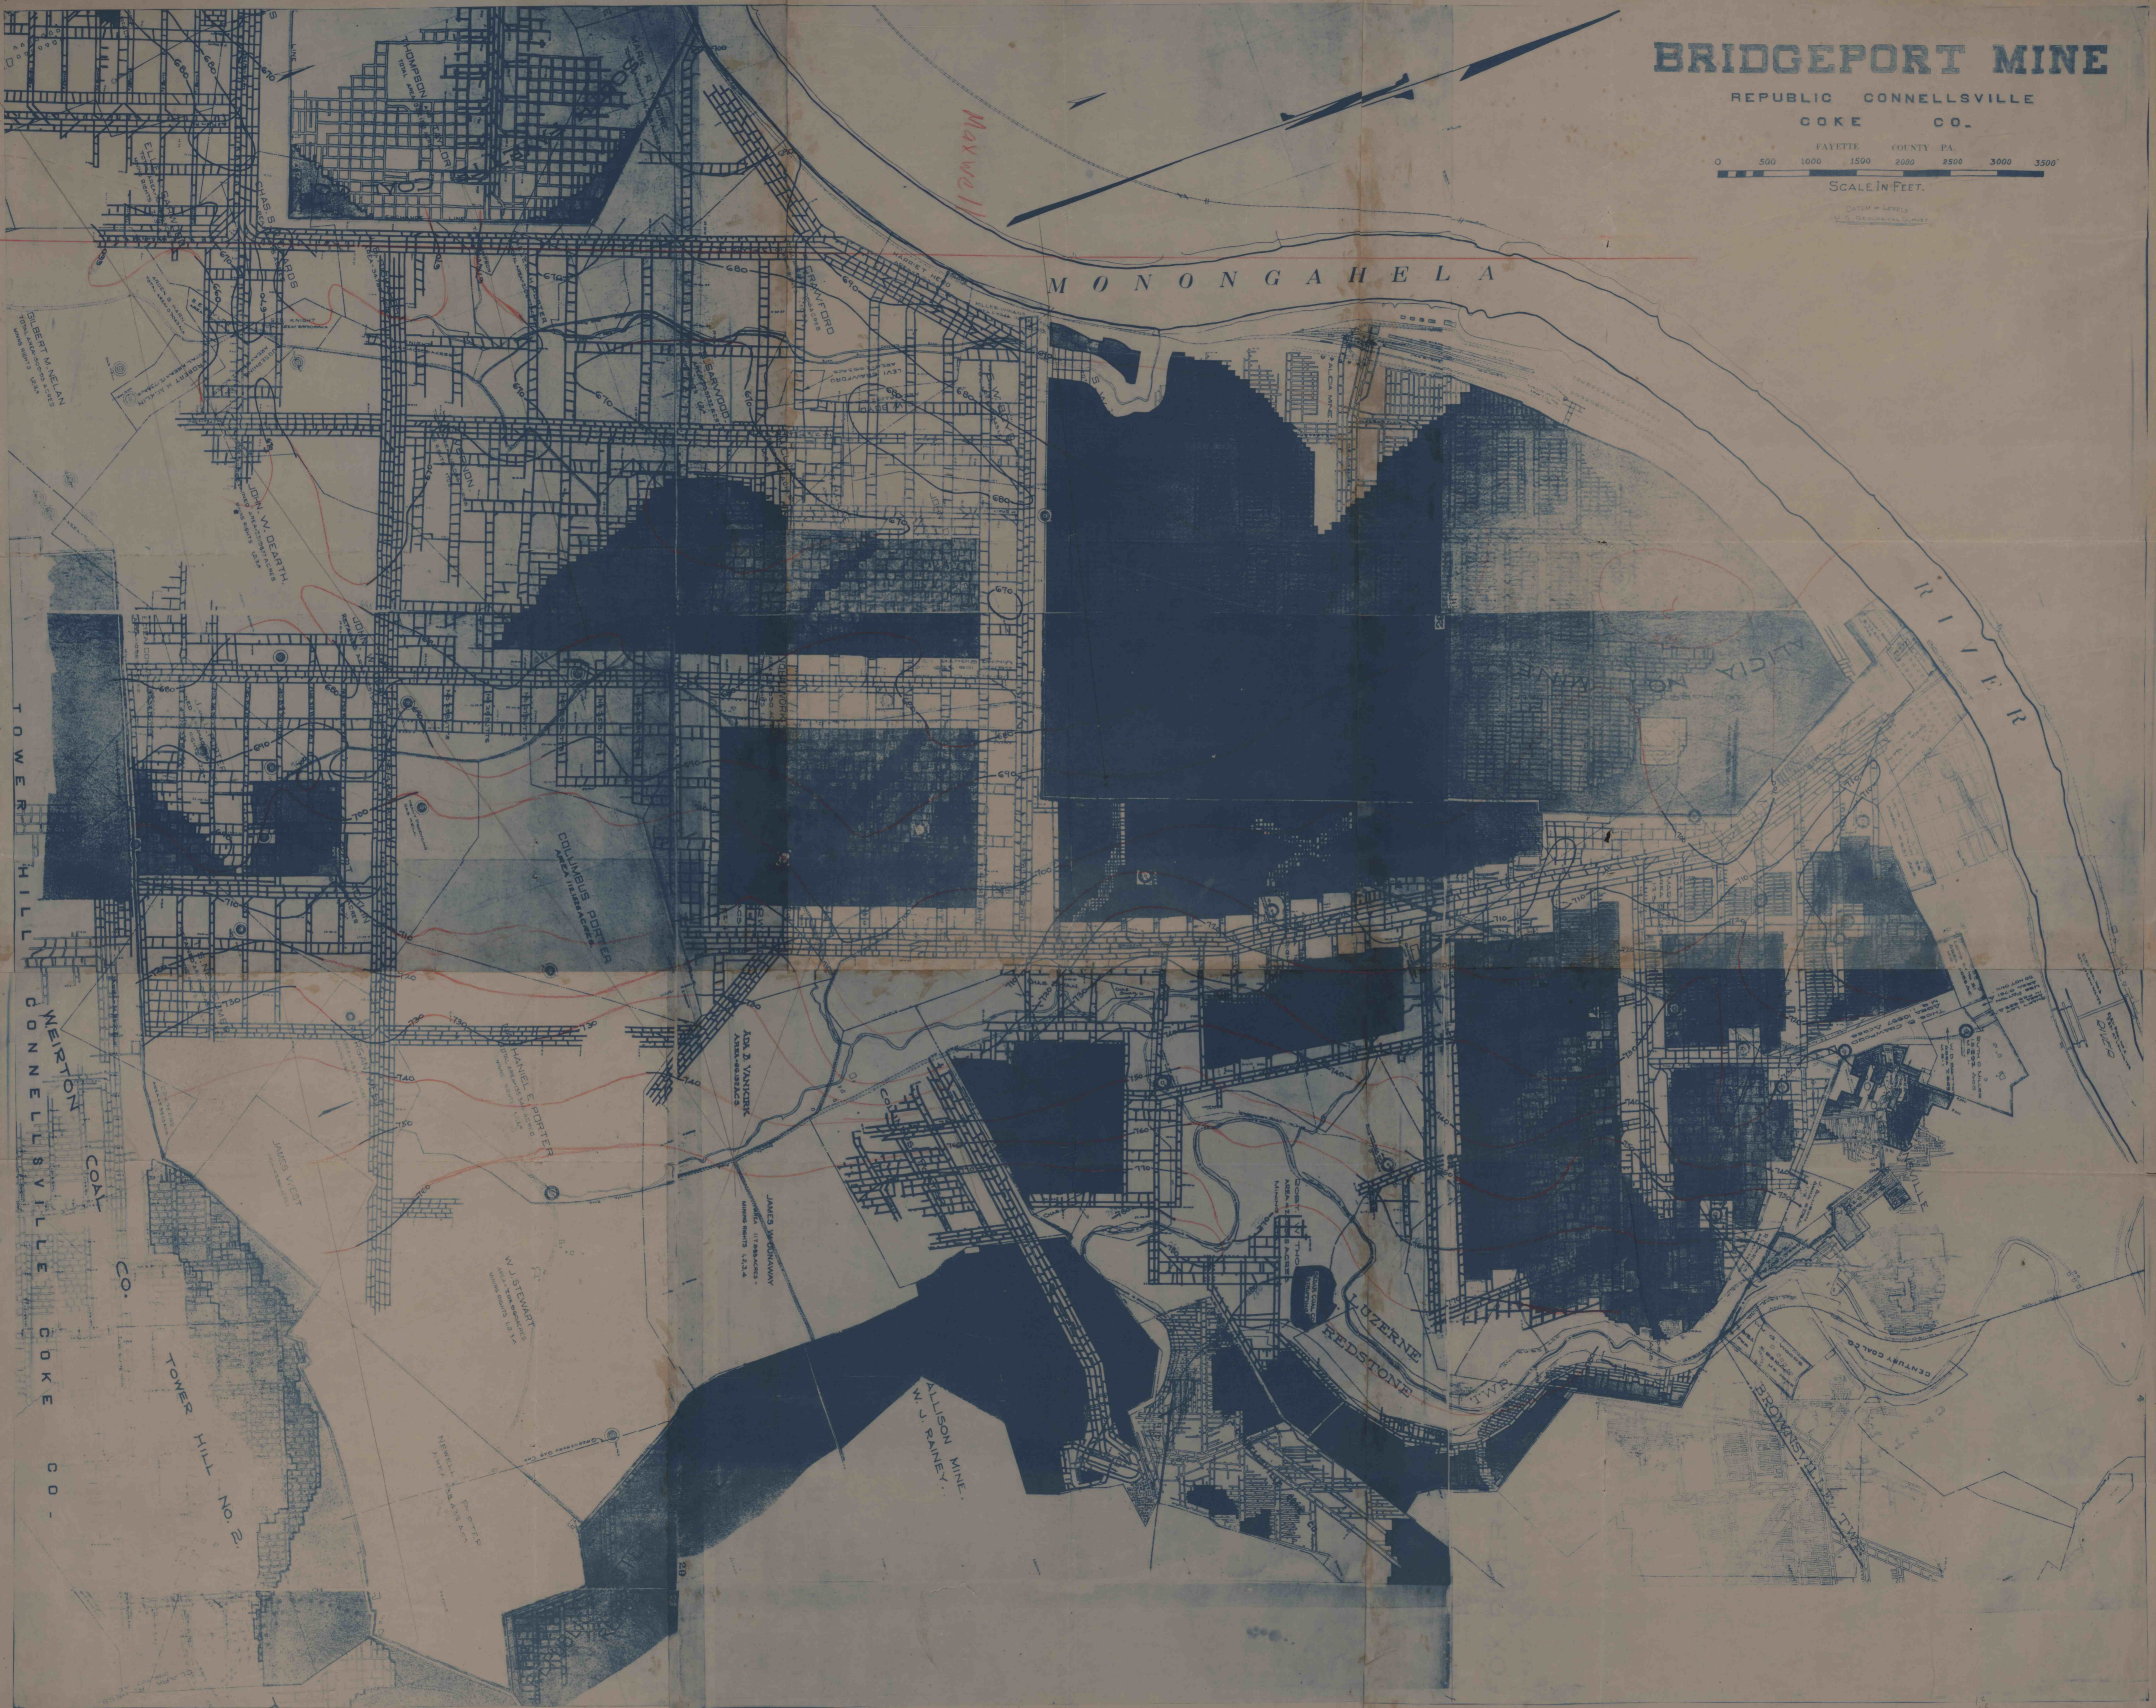

MONONGAHELA

RIVER

ALLISON MINE
W. J. RANEY

JAMES J. MCDONALD





TOWER HILL
CONNELLVILLE COKE CO.

WEIRTON
CONNELLVILLE COKE CO.

TOWER HILL No. 2
CONNELLVILLE COKE CO.

Maxwell

