
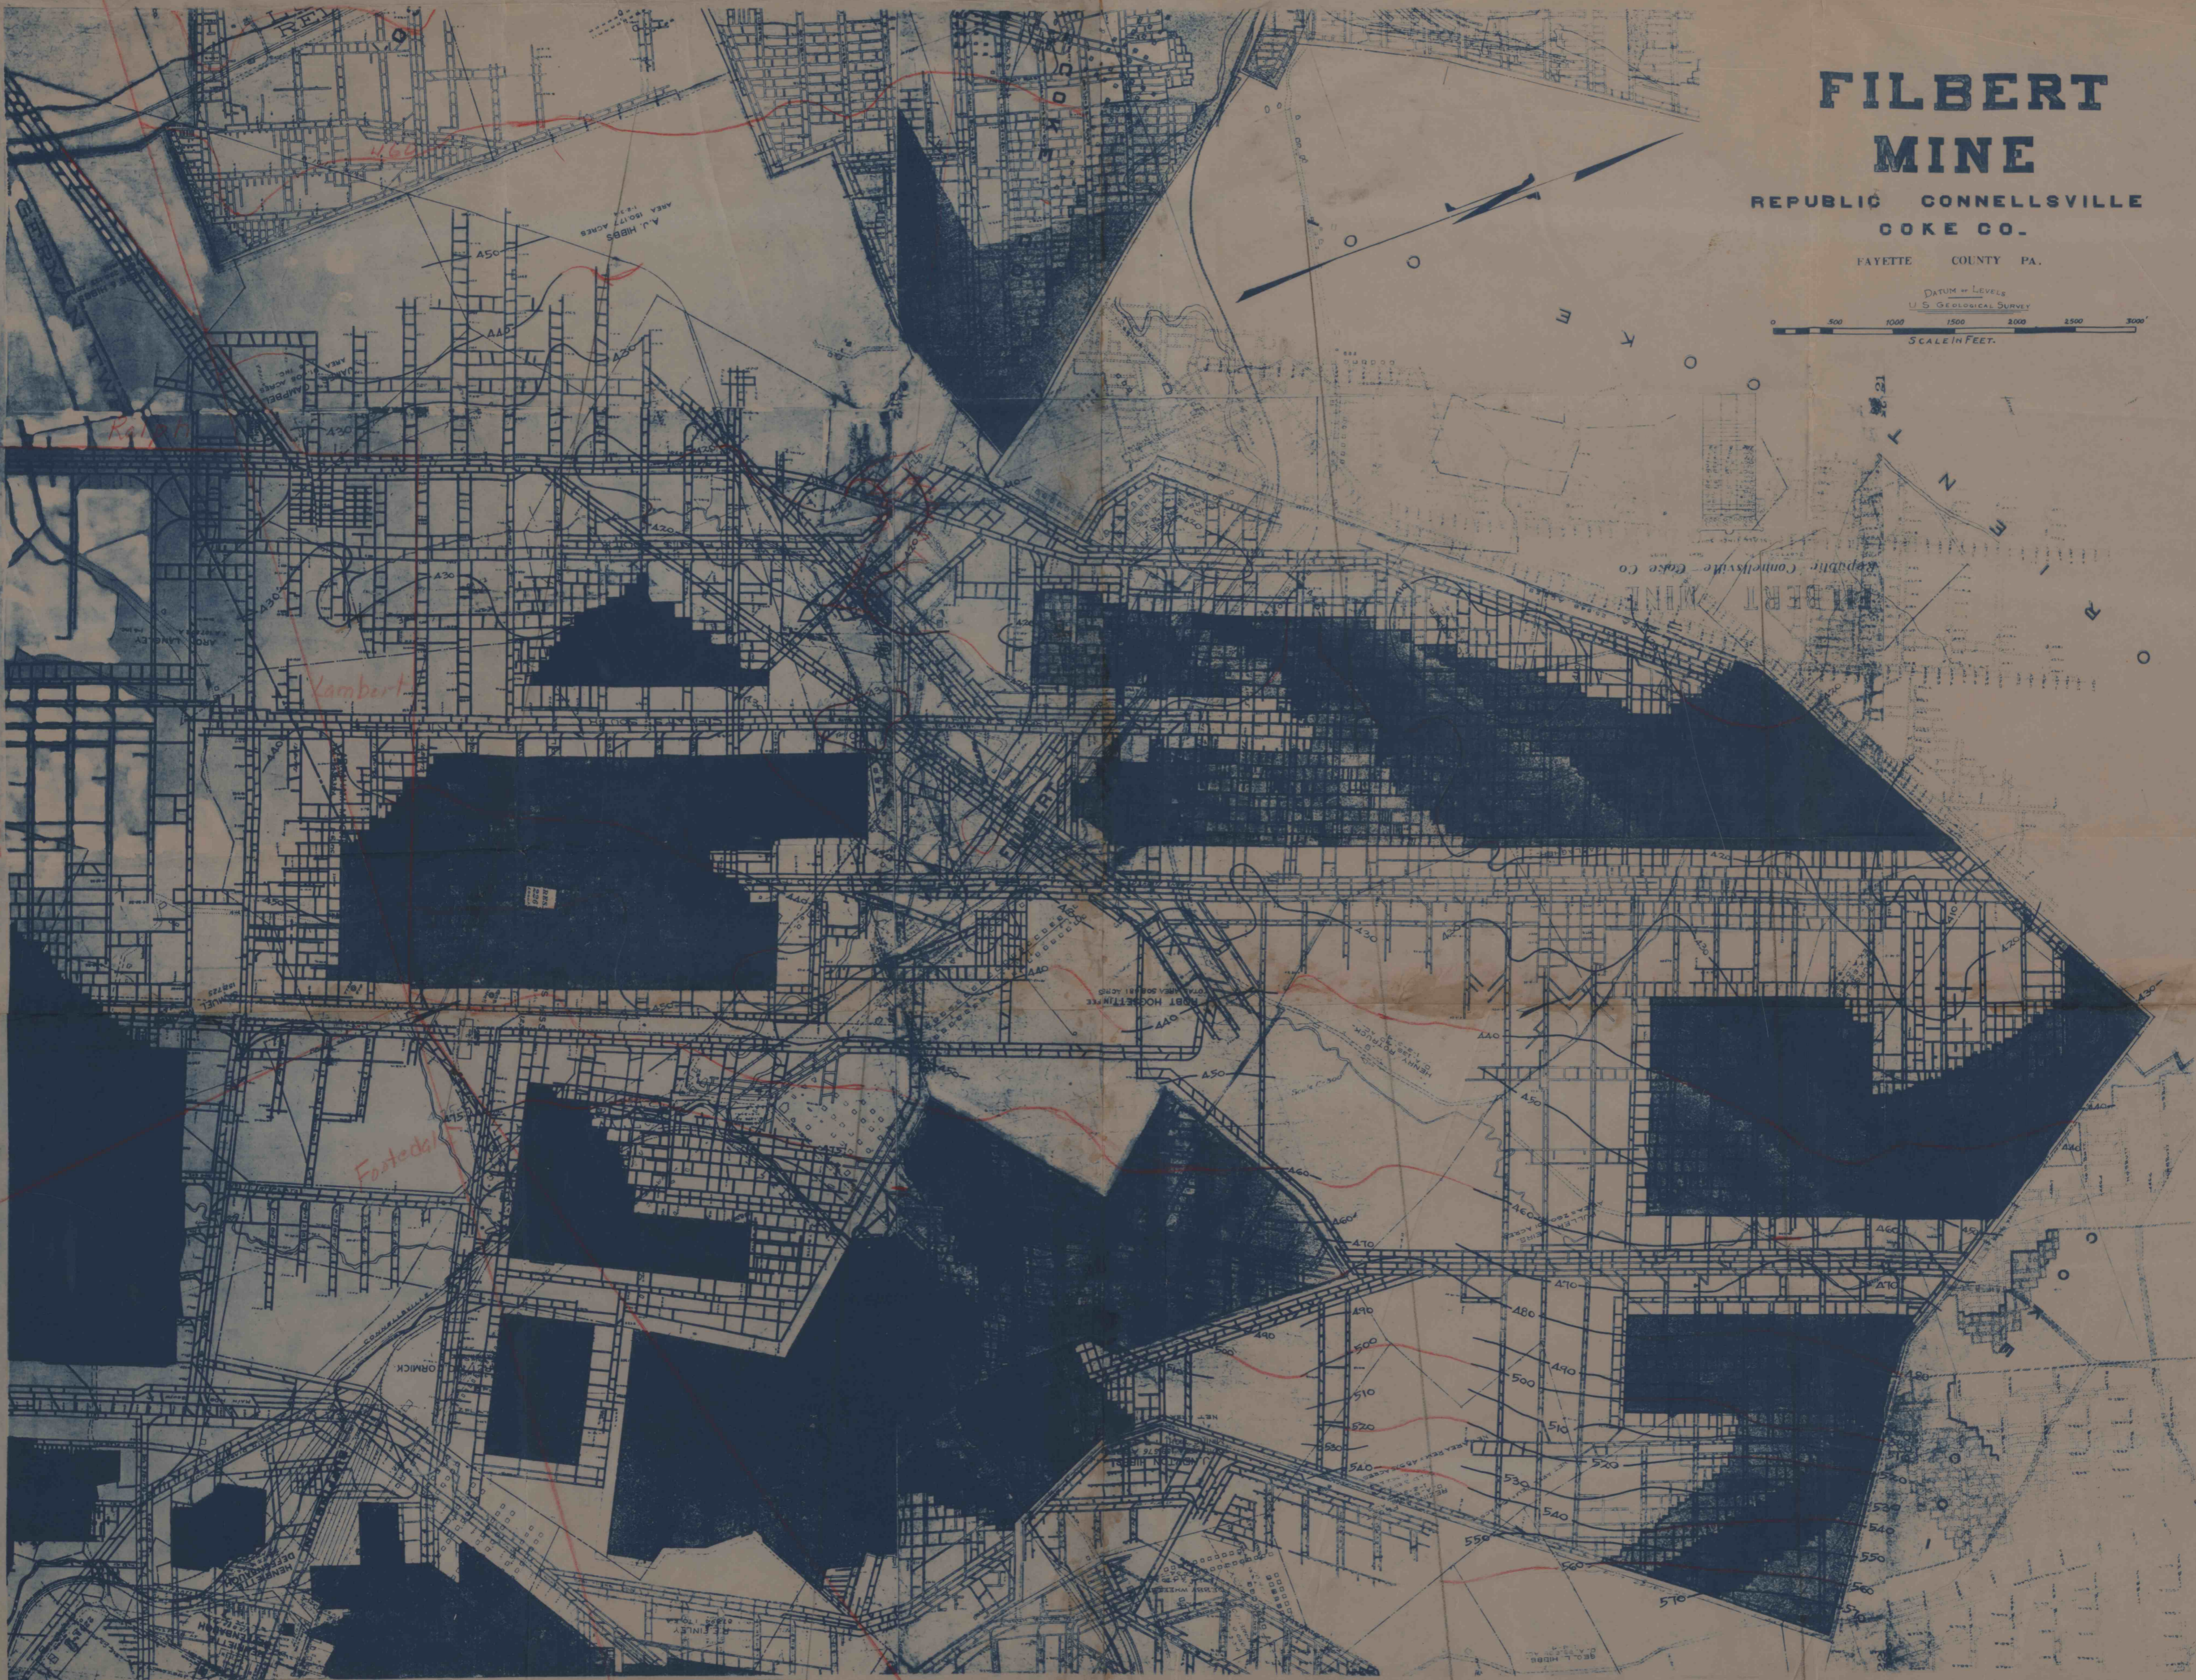


# FILBERT MINE

REPUBLIC CONNELLSVILLE  
COKE CO.

FAYETTE COUNTY PA.

DATUM OF LEVELS  
U. S. GEOLOGICAL SURVEY

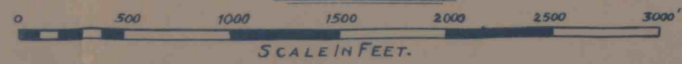

Lambert

Kambert

Footedale

Footedale