


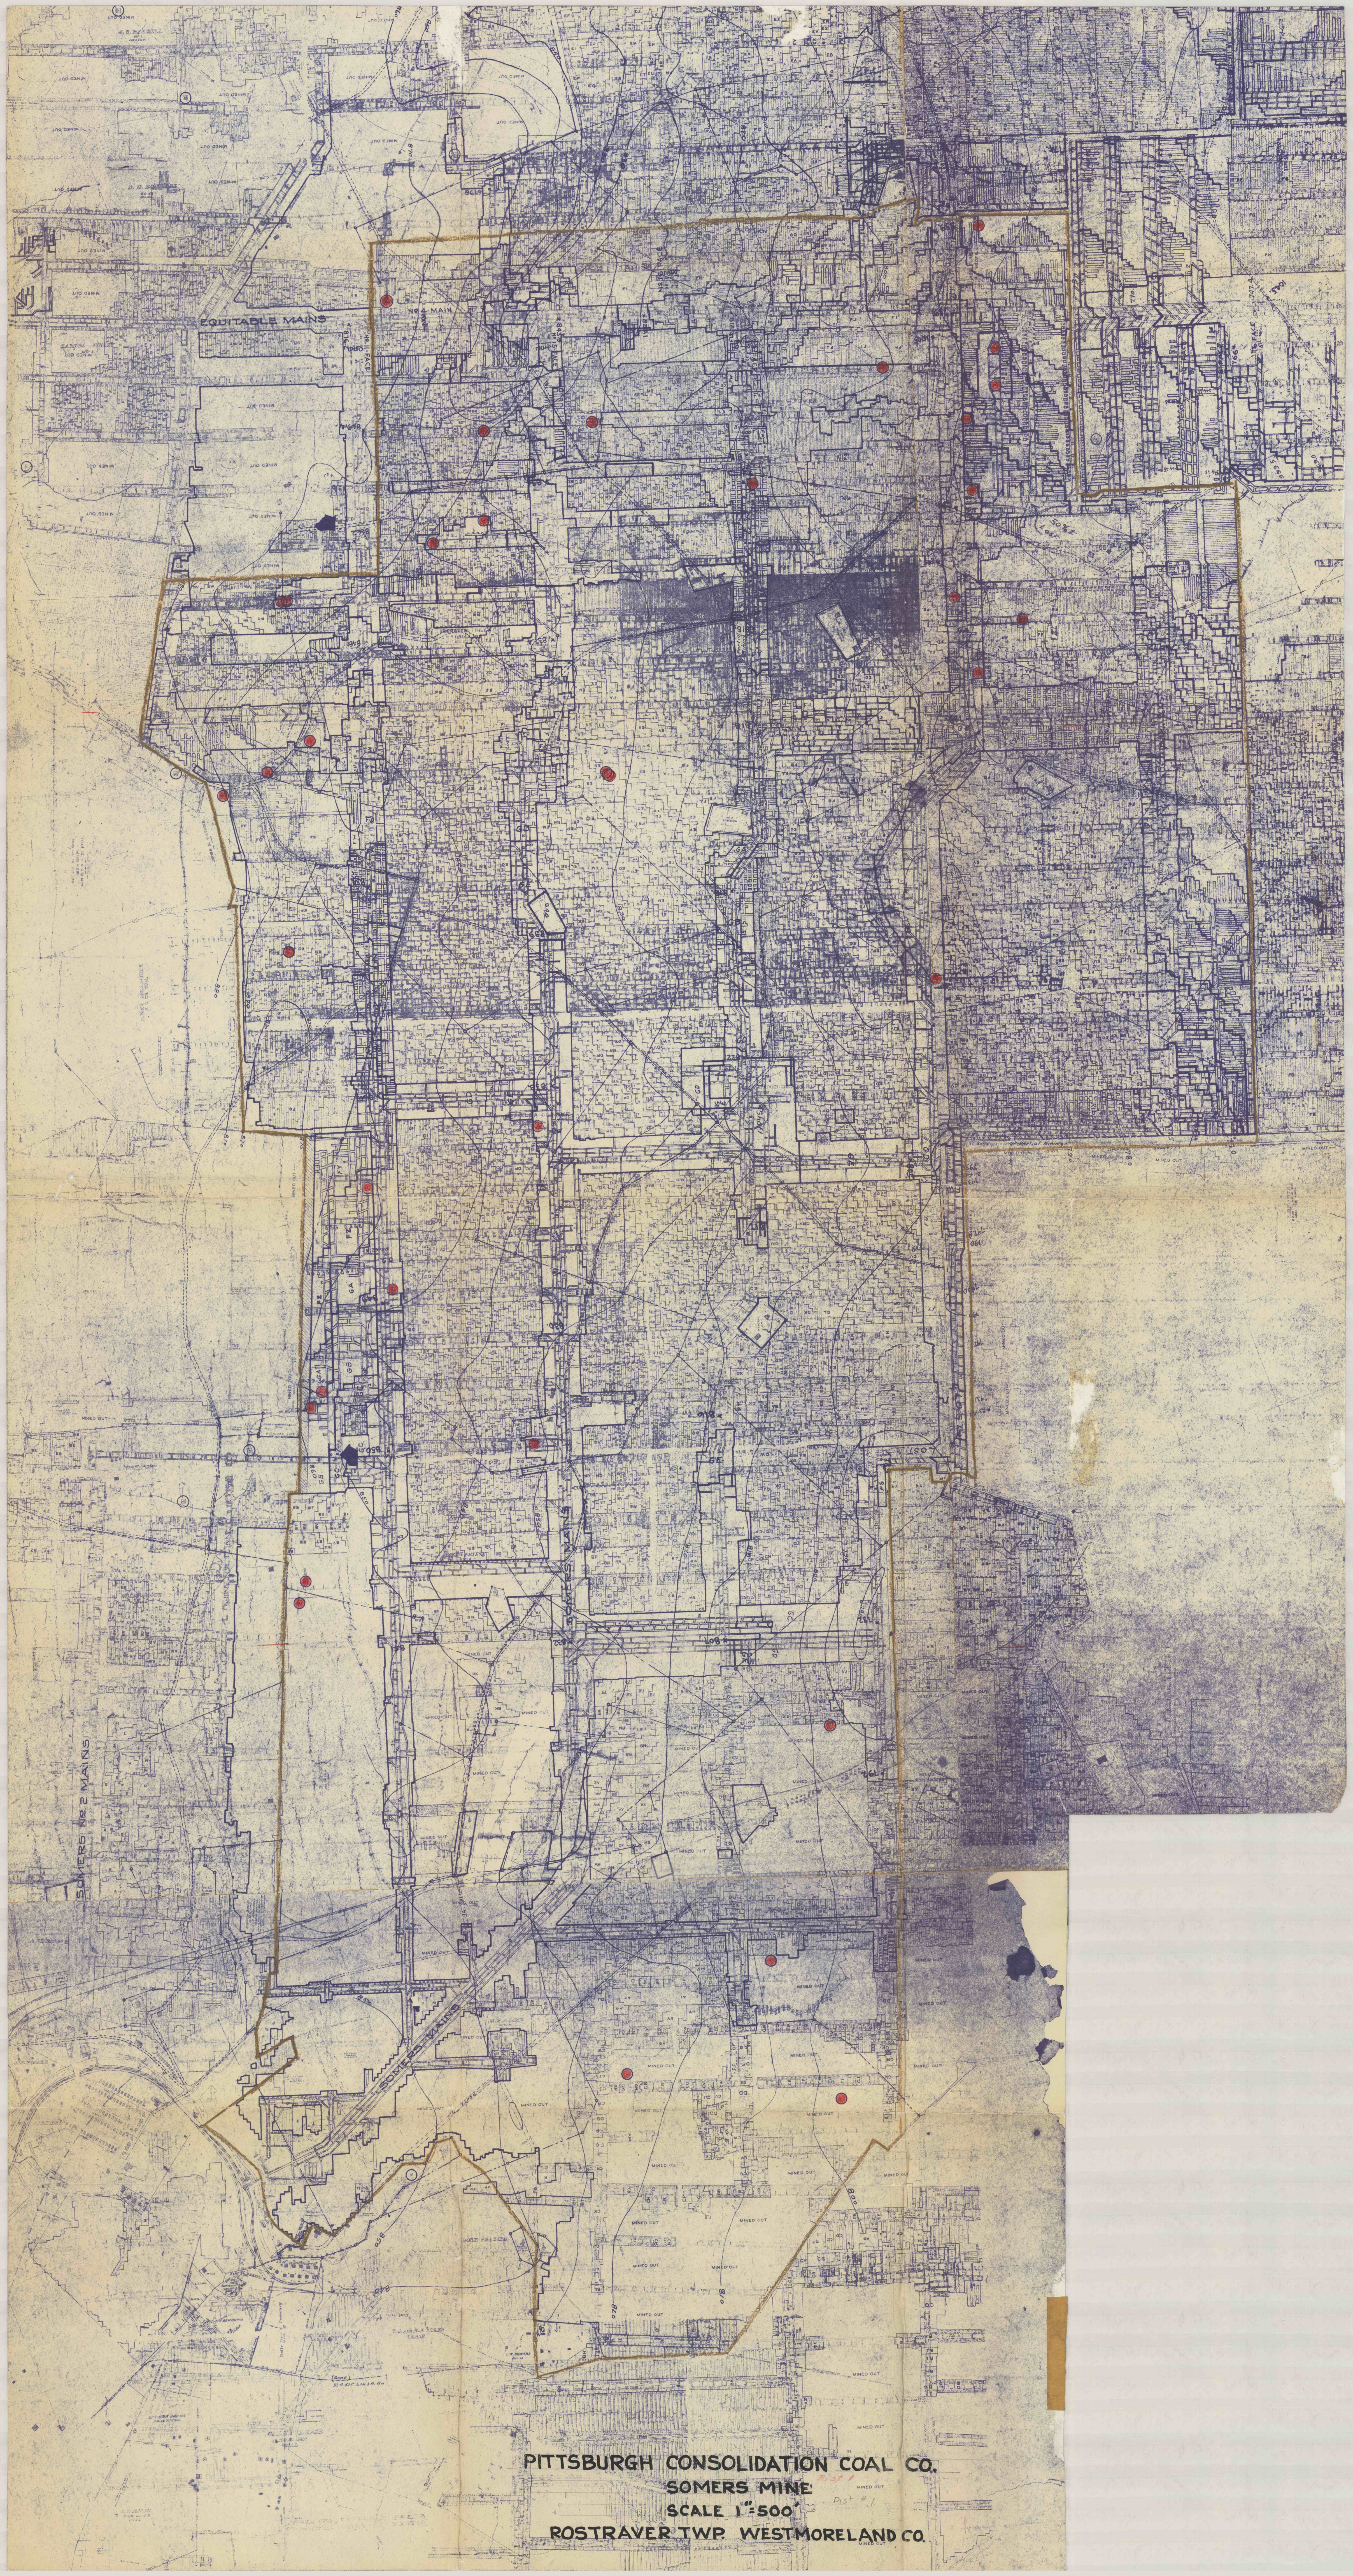

PITTSBURGH CONSOLIDATION COAL CO.
SOMERS MINE
SCALE 1"=500'
ROSTRAVER TWP WESTMORELAND CO.