


Calcutt M  
Drawing 2

PGH. COAL COMPANY  
WESTLANDS ALLOCATION

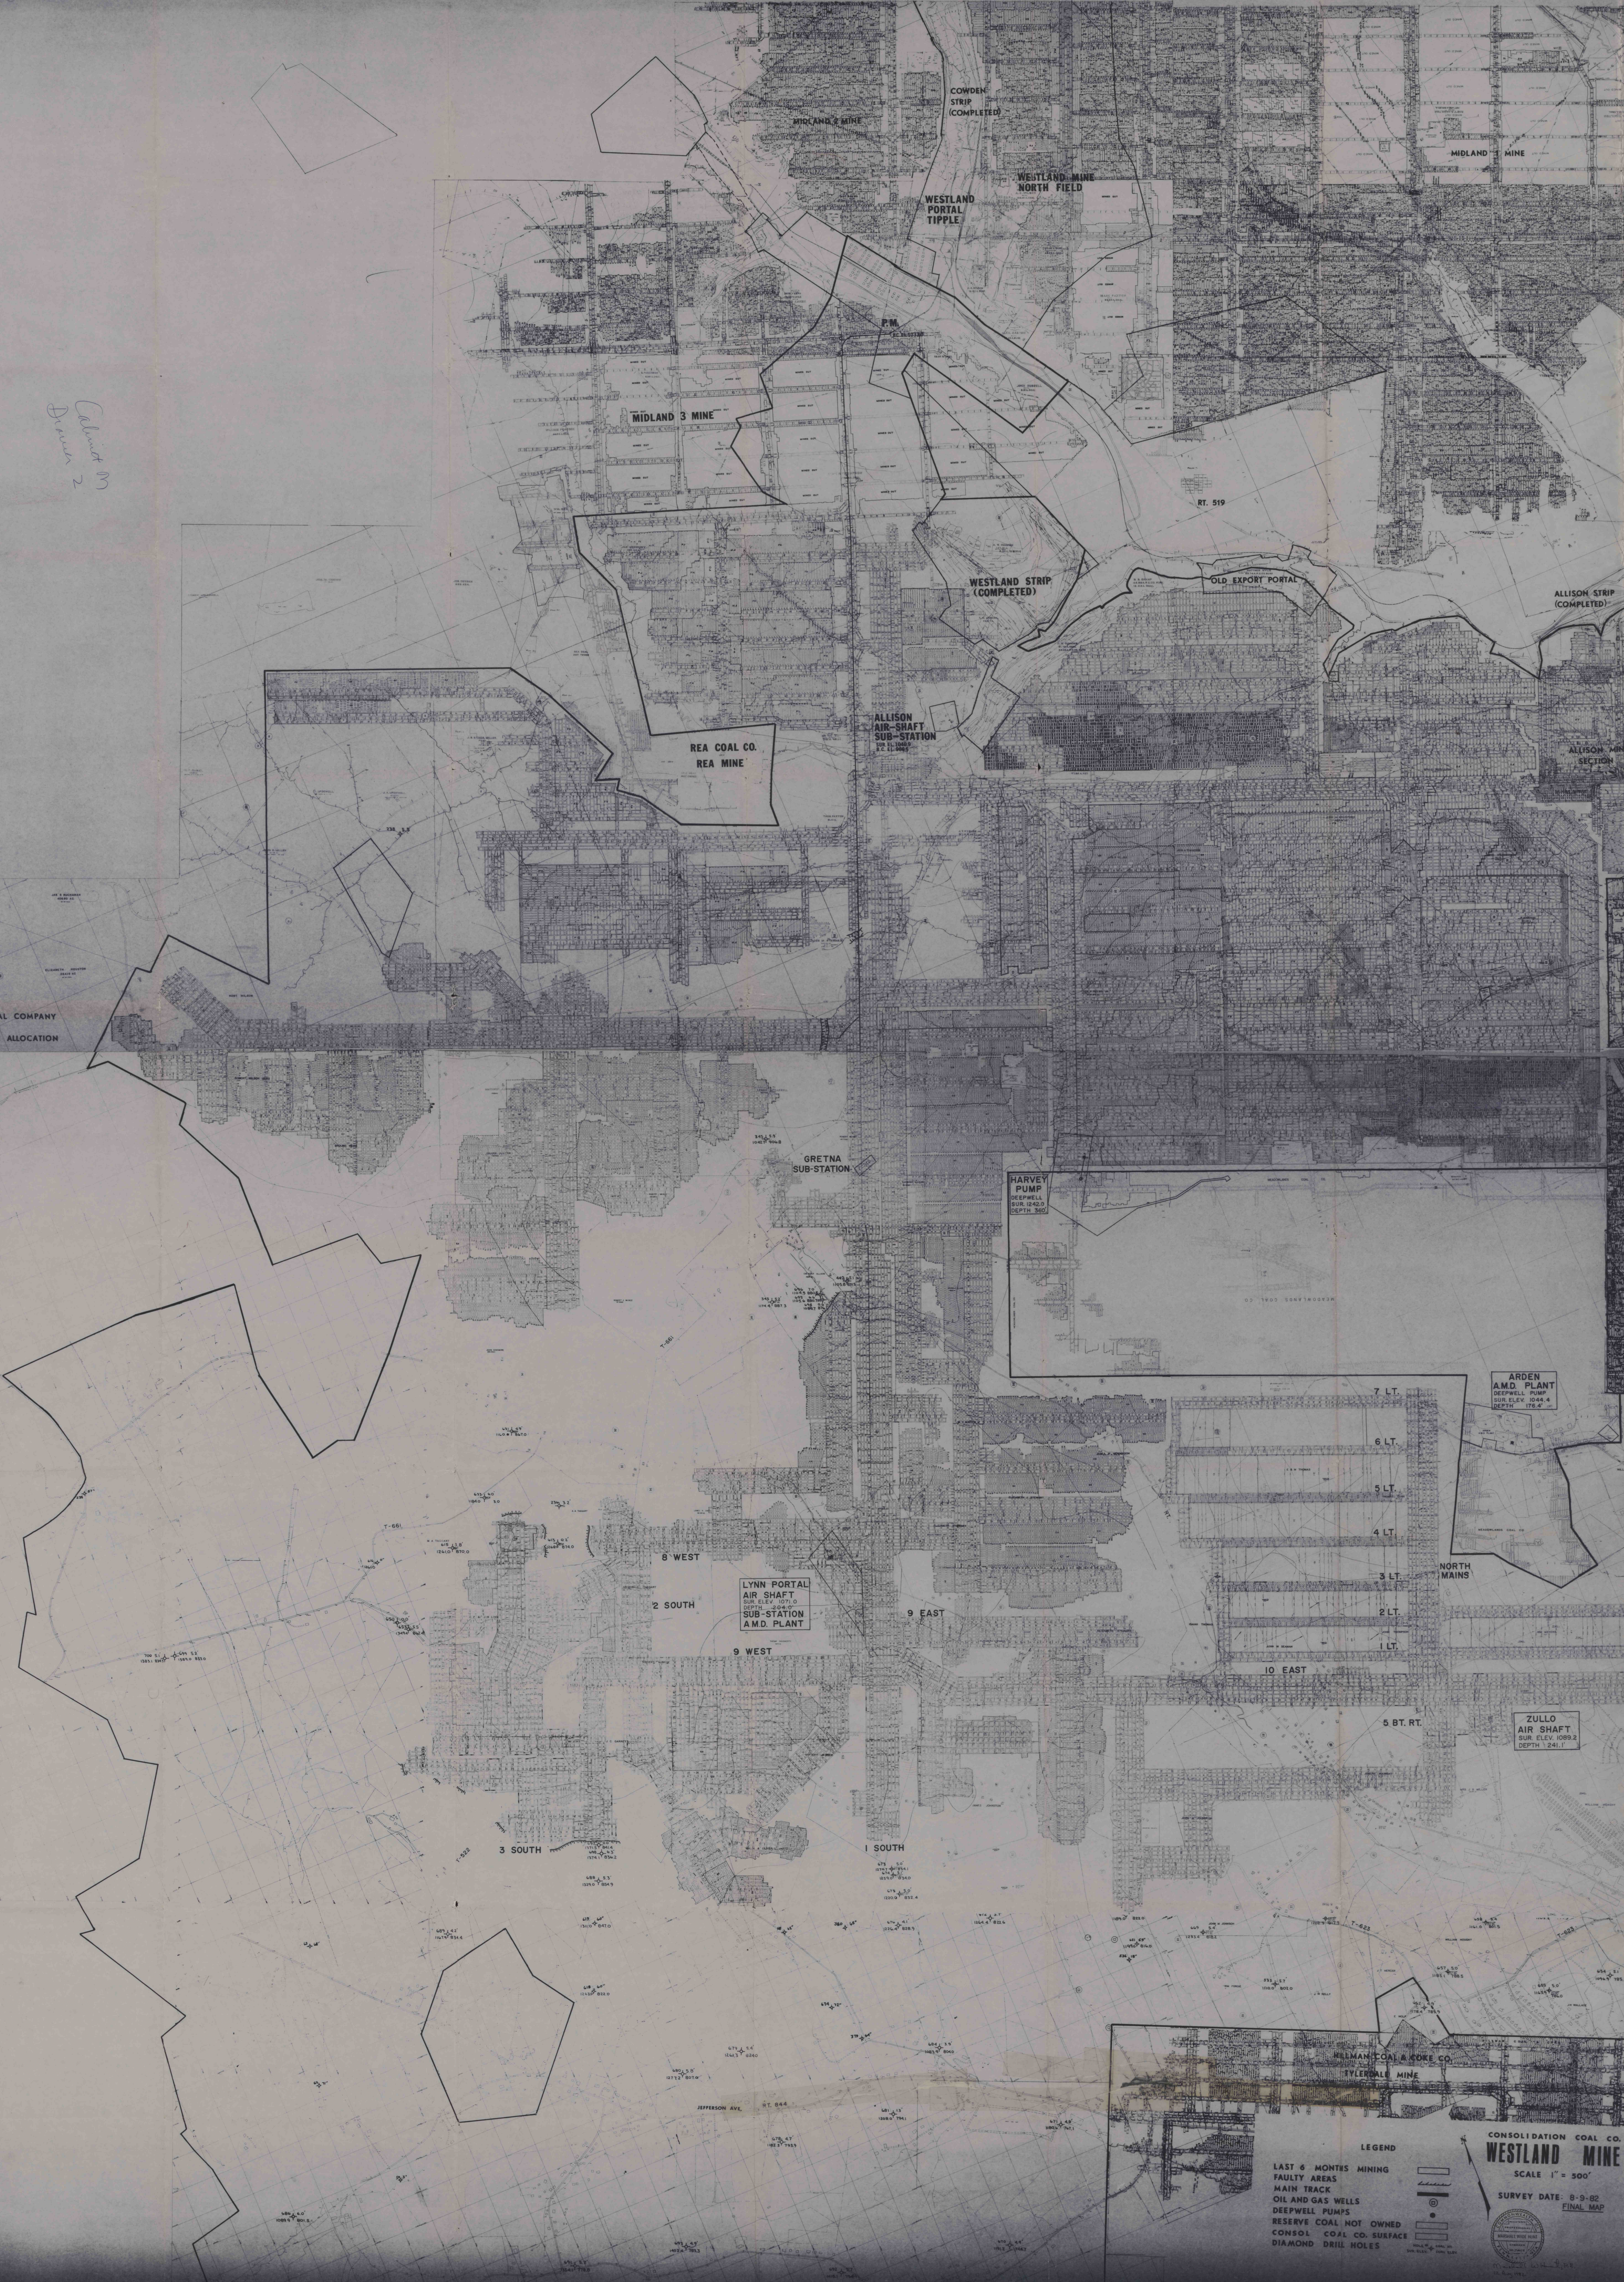

**LEGEND**

- LAST 6 MONTHS MINING
- FAULTY AREAS
- MAIN TRACK
- OIL AND GAS WELLS
- DEEPWELL PUMPS
- RESERVE COAL NOT OWNED
- CONSOL. COAL CO. SURFACE
- DIAMOND DRILL HOLES

**CONSOLIDATION COAL CO.**  
**WESTLAND MINE**  
SCALE 1" = 500'  
SURVEY DATE: 8-9-02  
FINAL MAP