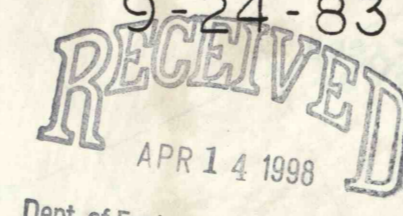


WESTLAND #2 MINE
CONSOLIDATION COAL COMPANY
EASTERN REGION
450 RACETRACK ROAD
WASHINGTON, PENNSYLVANIA

MT. PLEASANT TWP, WASHINGTON CO., PA.

SURVEY DATE: 9-24-83 **SCALE: 1"=500'**

FINAL MAP

TEMPORARILY
ABANDONED
9-24-83


 Cabinet M
 Dr 2

