

LEGEND

DRILL HOLES

- COAL INTERSECTED OF MINEABLE THICKNESS
- ◐ COAL INTERSECTED BELOW MINEABLE THICKNESS
- NO COAL INTERSECTED

CORE HOLES

- ⊙ COAL INTERSECTED OF MINEABLE THICKNESS
- ⊖ COAL INTERSECTED BELOW MINEABLE THICKNESS
- ⊘ NO COAL INTERSECTED

1982 WORKINGS

FAULTY AREAS

MAIN TRACK

ABD - ACTIVE WELLS

MG SETS - RECTIFIERS

PUMPS TO OUTSIDE

RESERVES


SURFACE OWNED

BELT

1983

JANUARY	JULY
FEBRUARY	AUGUST
MARCH	SEPTEMBER
APRIL	OCTOBER
MAY	NOVEMBER
JUNE	DECEMBER

RENTON MINE
1986
1"=500'

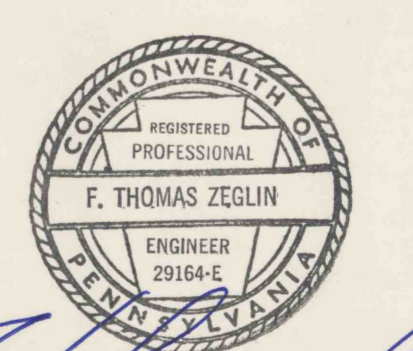

F. Thomas Zeglin