


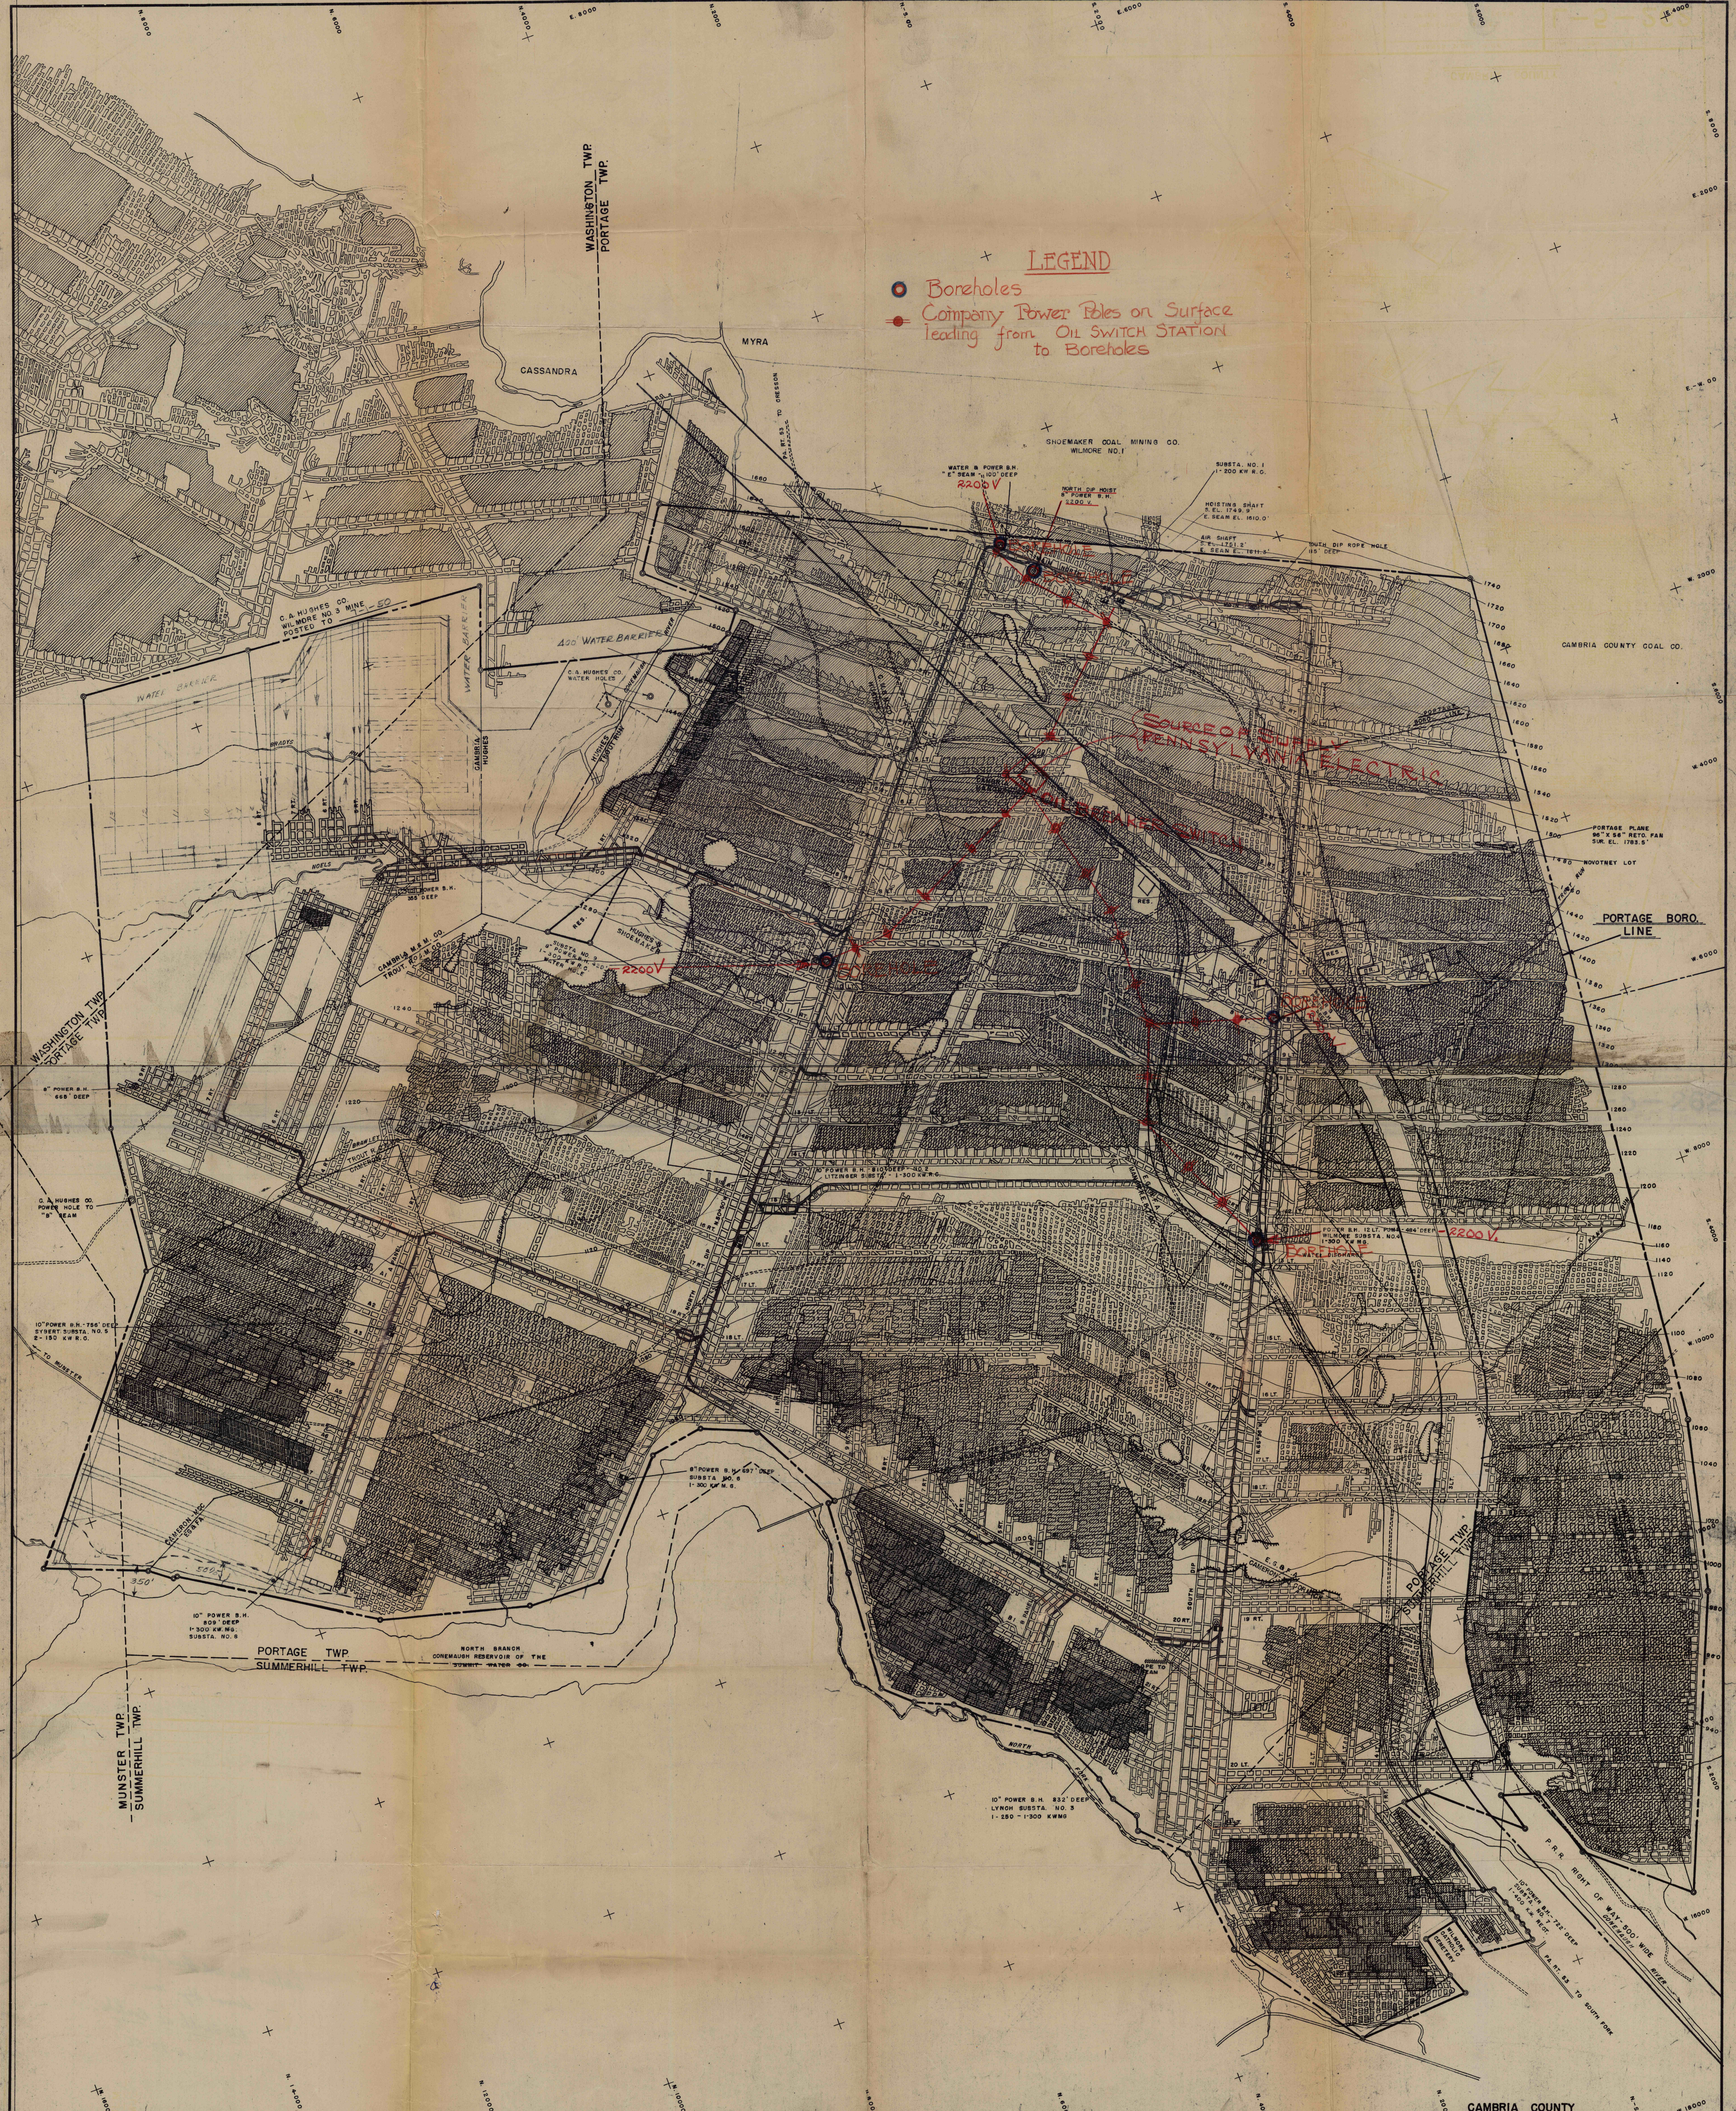

LEGEND

- Boreholes
- Company Power Bles on Surface leading from Oil Switch Station to Boreholes