


13.5	Acres
51.4	"
29.8	"
29.2	"
20.6	"
11.5	"
20.7	"
2.4	"
<u>176.41</u>	"

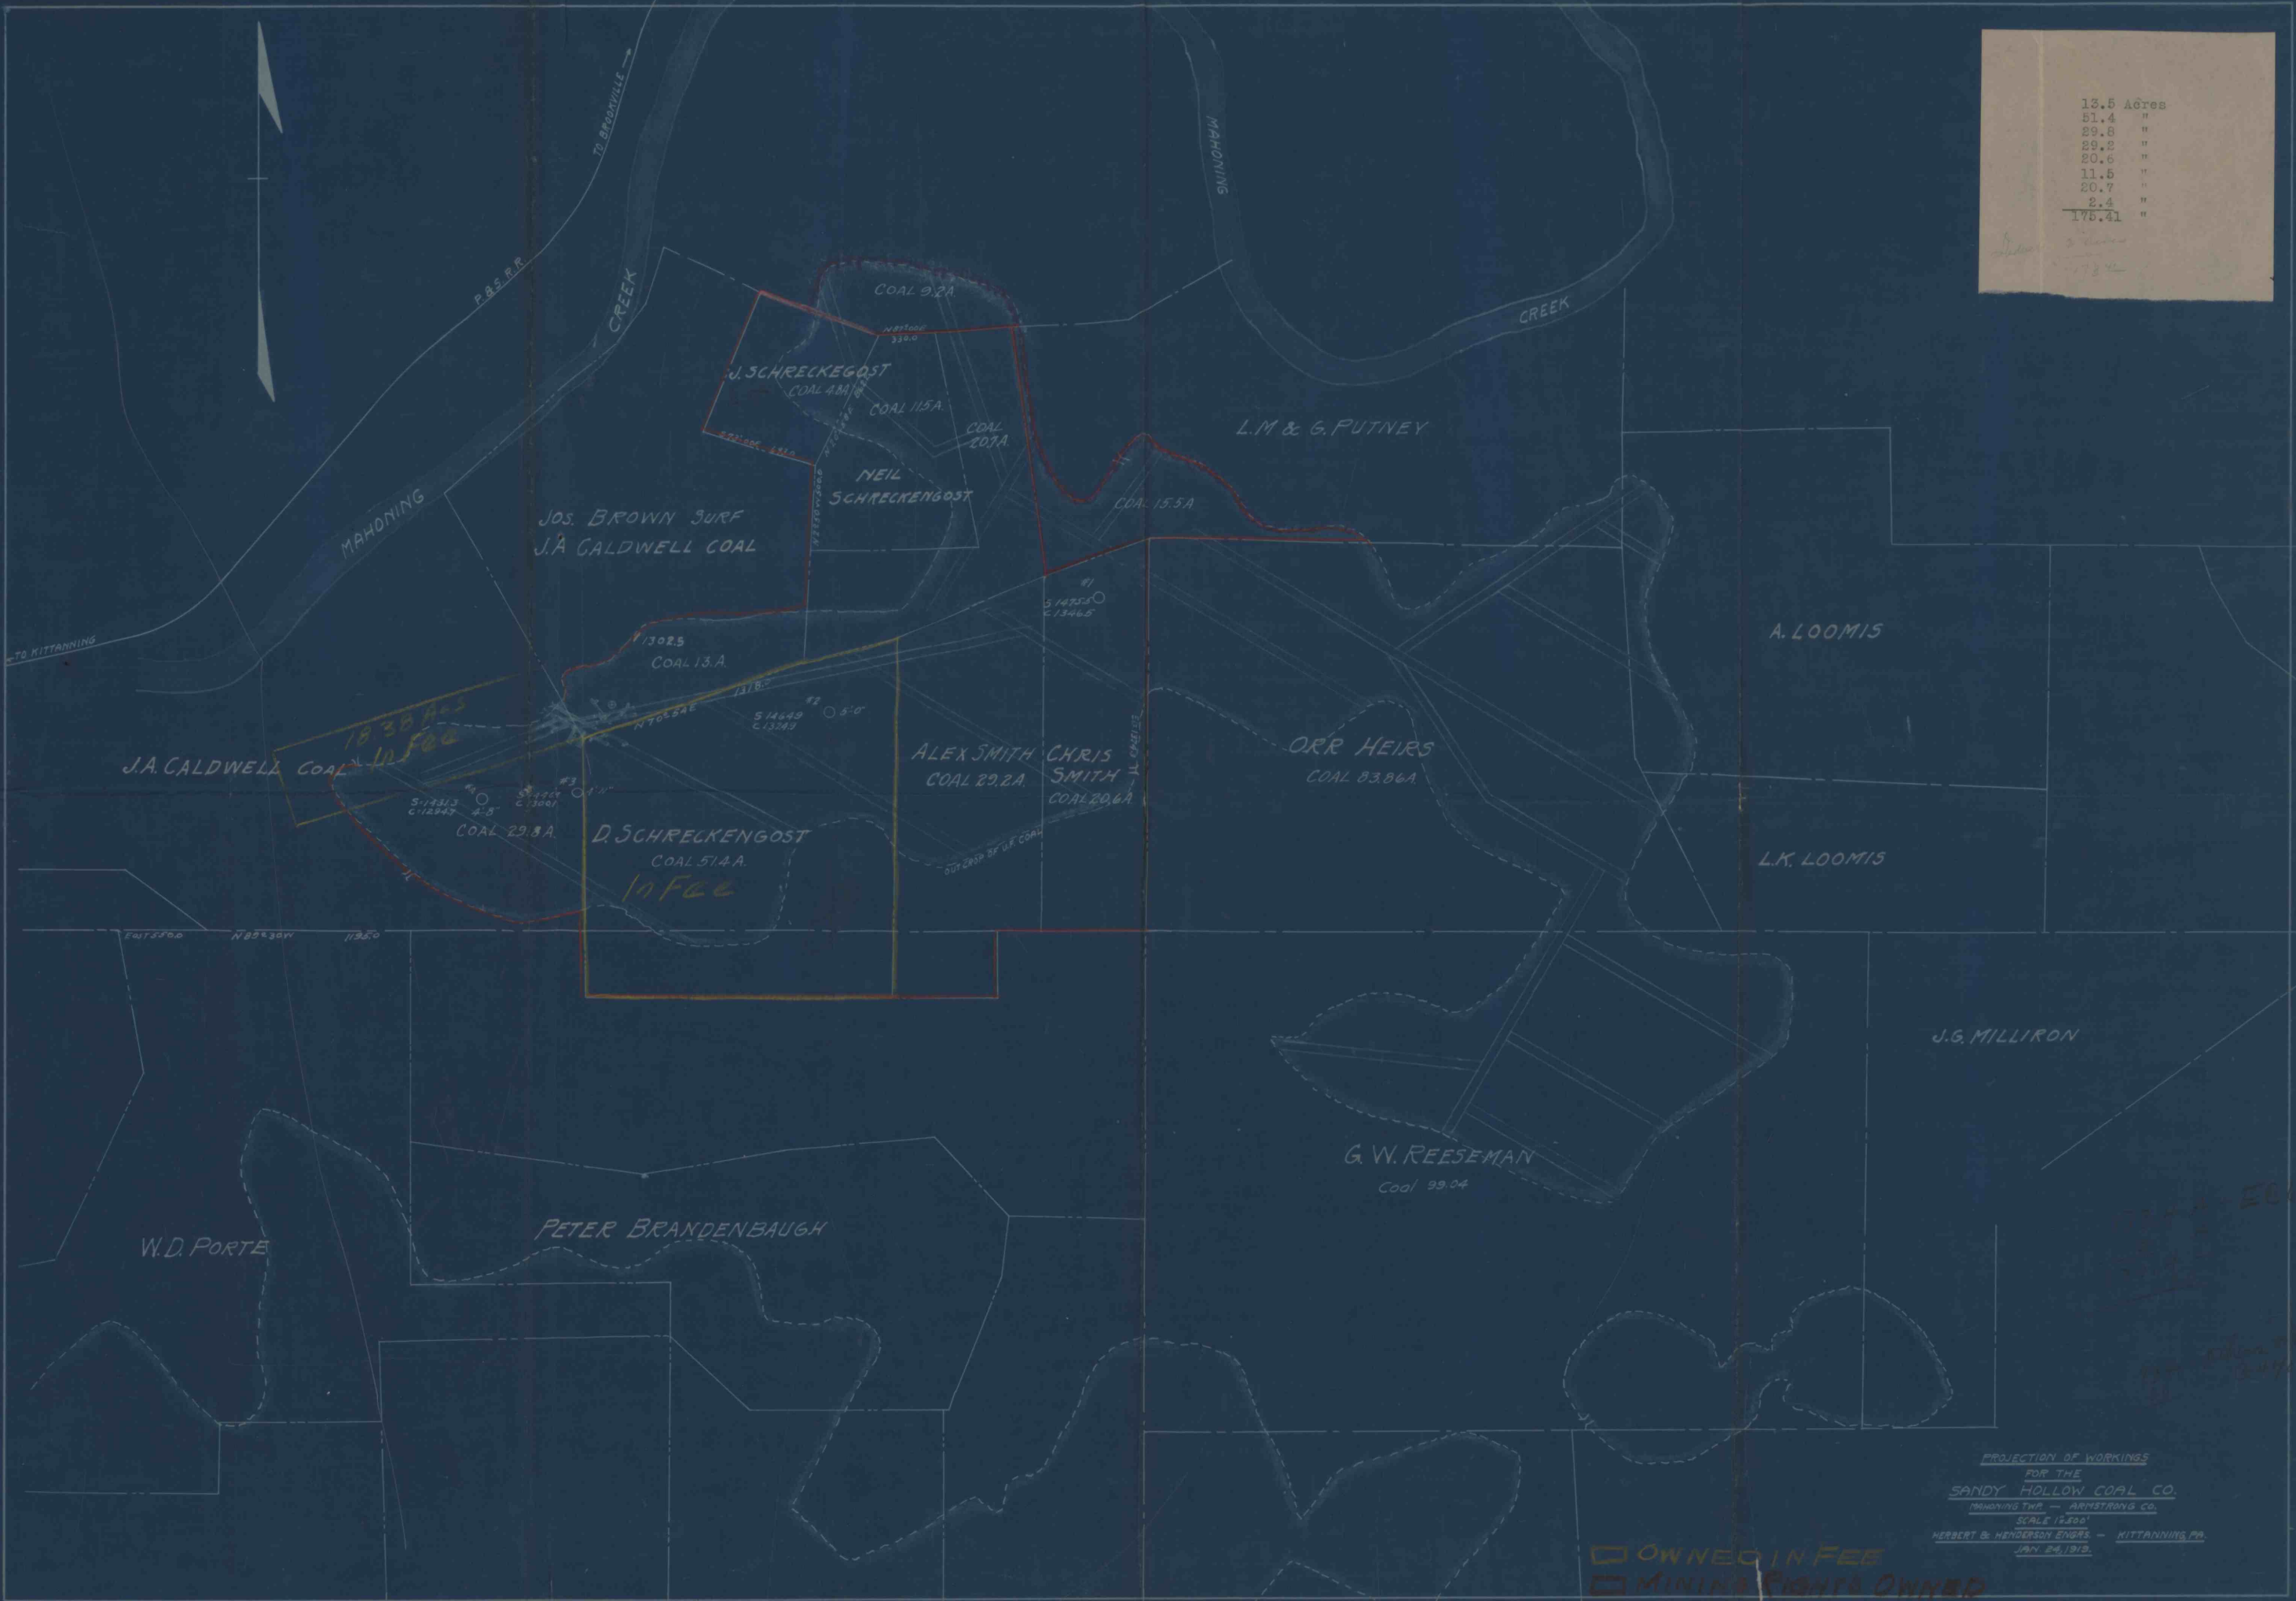

PROJECTION OF WORKINGS
 FOR THE
 SANDY HOLLOW COAL CO.
 MAHONING TWP. - ARMSTRONG CO.
 SCALE 1"=200'
 HERBERT B. HENDERSON ENGINEER - KITTANNING PA.
 JAN. 24, 1913.

OWNED IN FEE
 MINING RIGHTS OWNED

18.38 Acres
 10 Fee