


C FIT TO D  
D FIT TO C

FIT TO D  
FIT TO C

7-1-47  
MELCROFT NO. 1 MINE

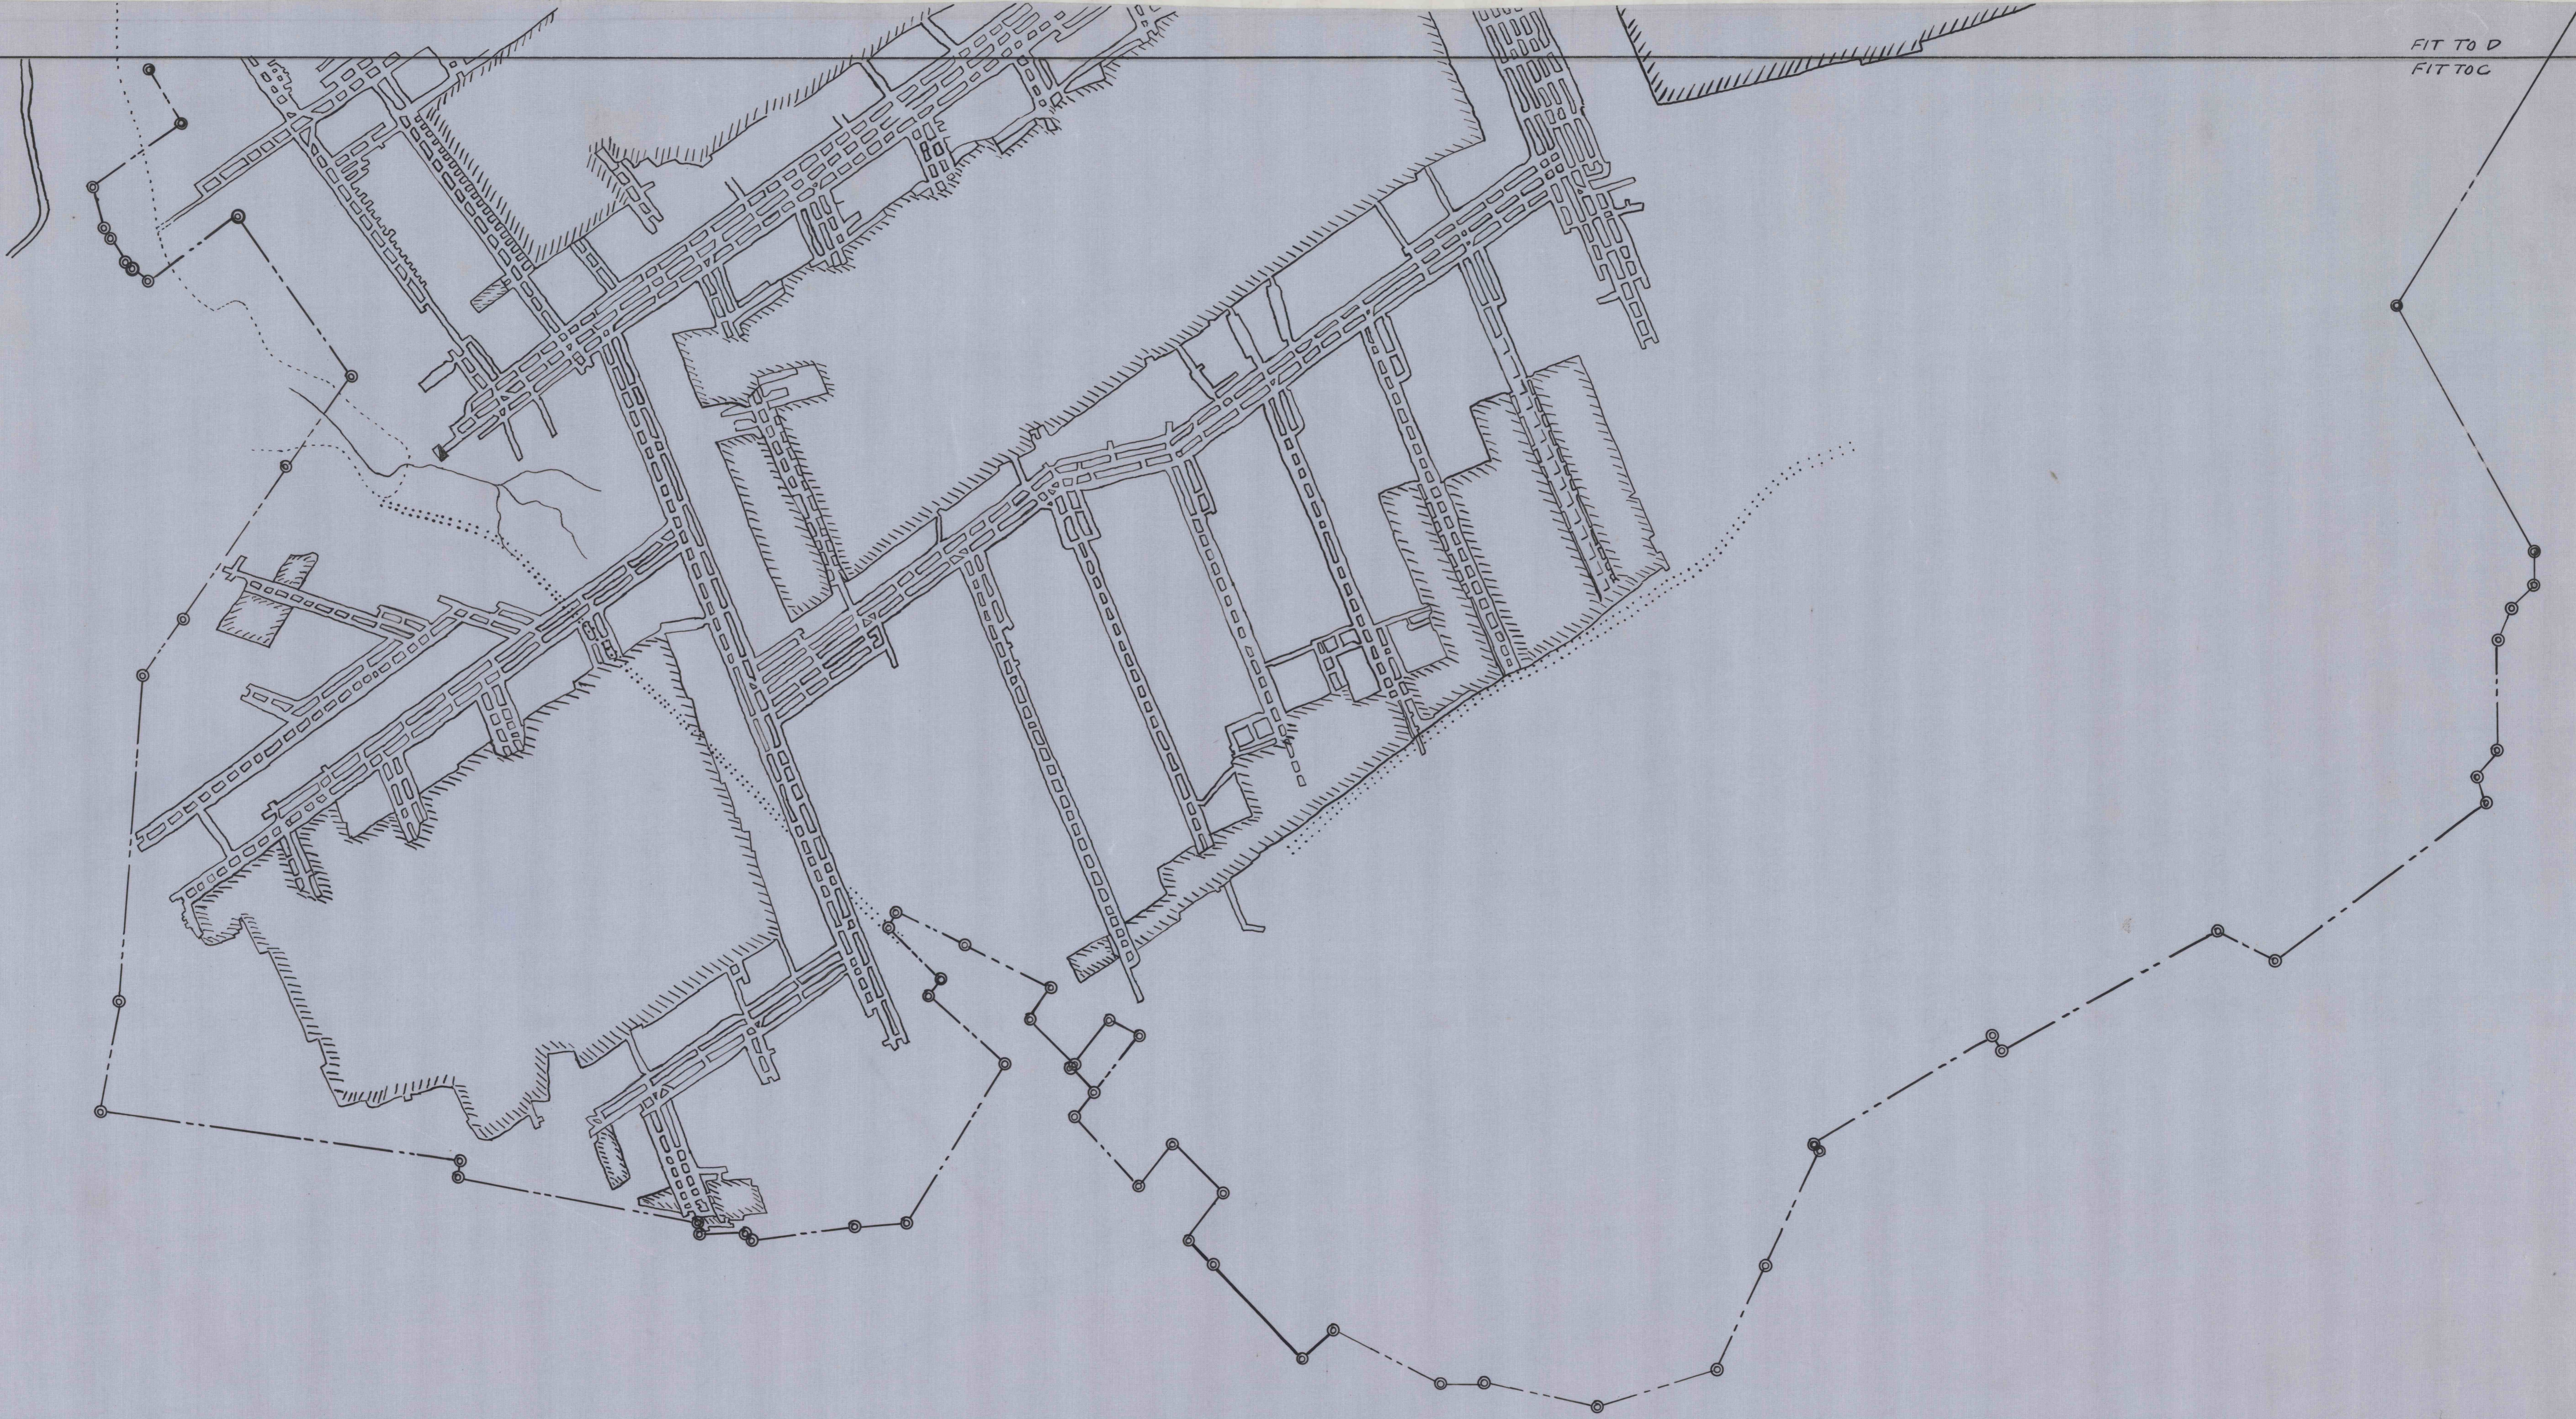

special  
ride