
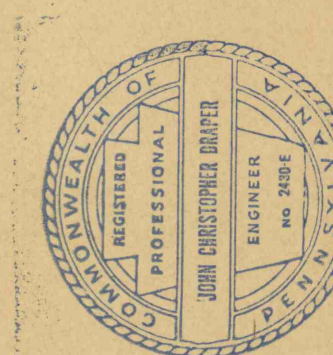


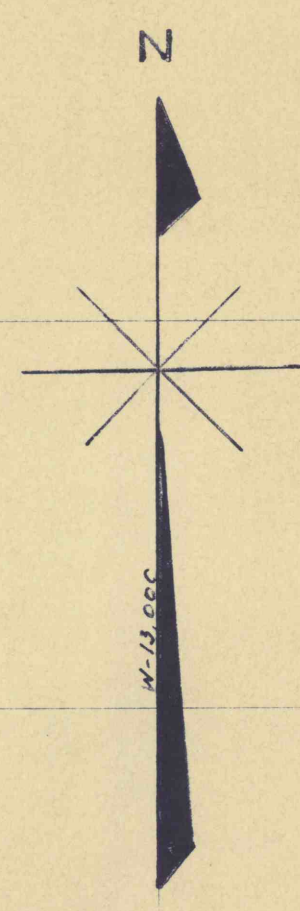

PROPERTIES
WARWICK MINE NO. 1
DUQUESNE LIGHT CO.
GREENSBORO GREENE CO. PA.
Scale 800 TO 1

MINE WORKINGS EXTENDED

12-31-54	6-30-55	12-31-55
6-30-56	12-31-56	6-30-57
12-31-57	6-30-58	12-31-58
6-30-59	12-31-59	6-30-60
12-31-60	6-30-61	12-31-61
6-30-62	12-31-62	6-30-63
12-31-63	6-30-64	12-31-64
6-30-65	12-31-65	6-30-66
12-31-66	6-30-67	12-31-67

Print
Numbers

