


THLEHEM MINES CORP.  
 ELLSWORTH DIV.  
 MINE # 58 SHEET # 2

REPUBLIC S  
 CLYDE

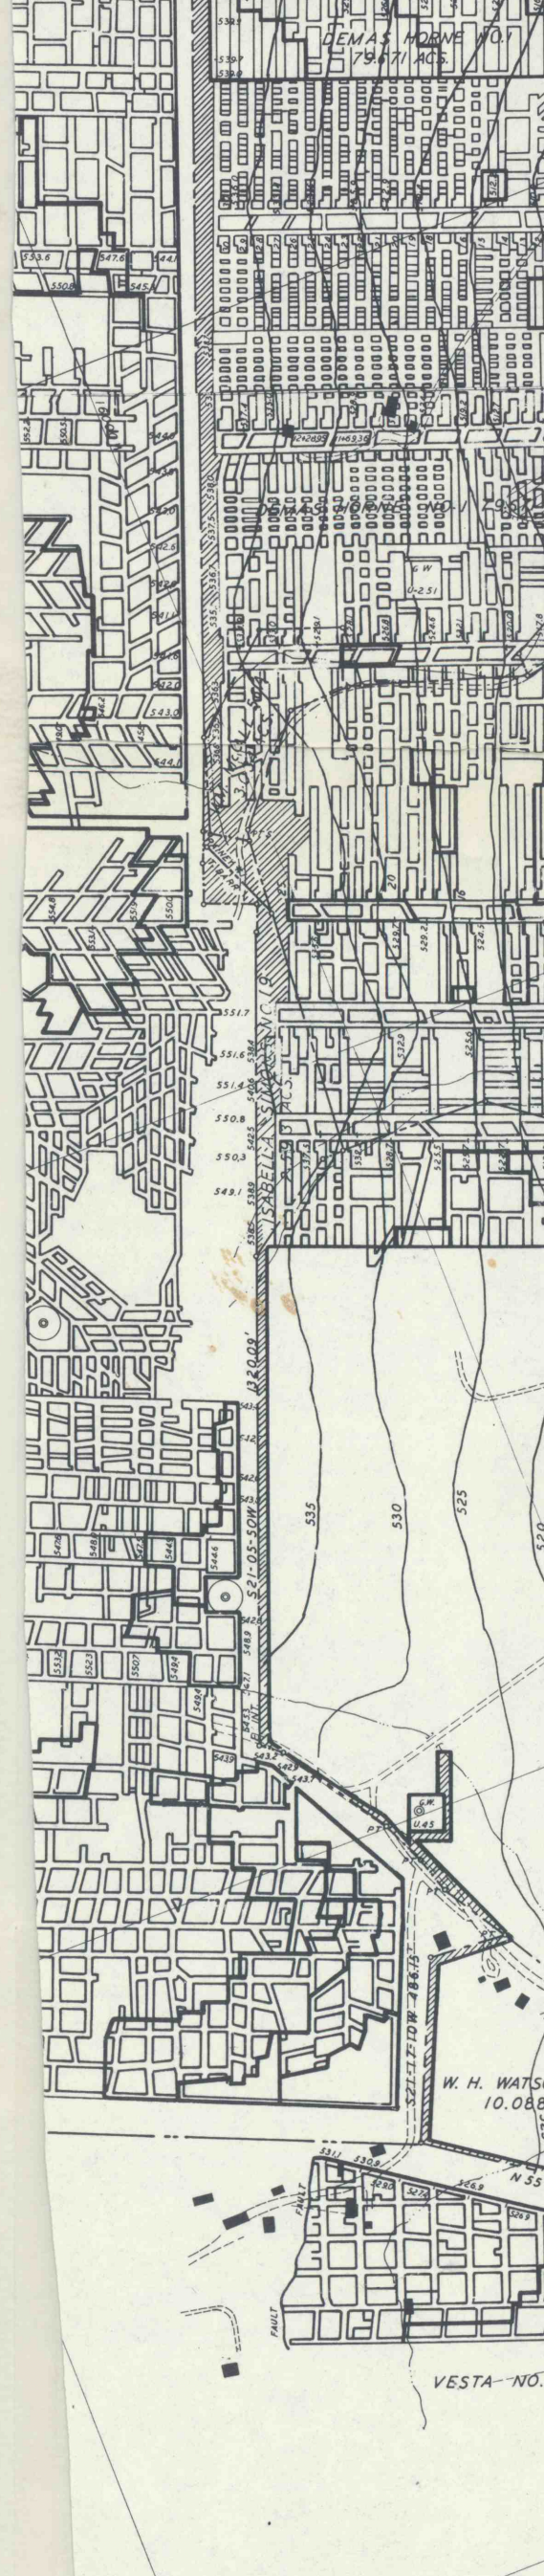

HEM MINES CORP.  
 SWORTH DIV.  
 # 58 SHEET # 1

BE  
 E

W 210.00'