


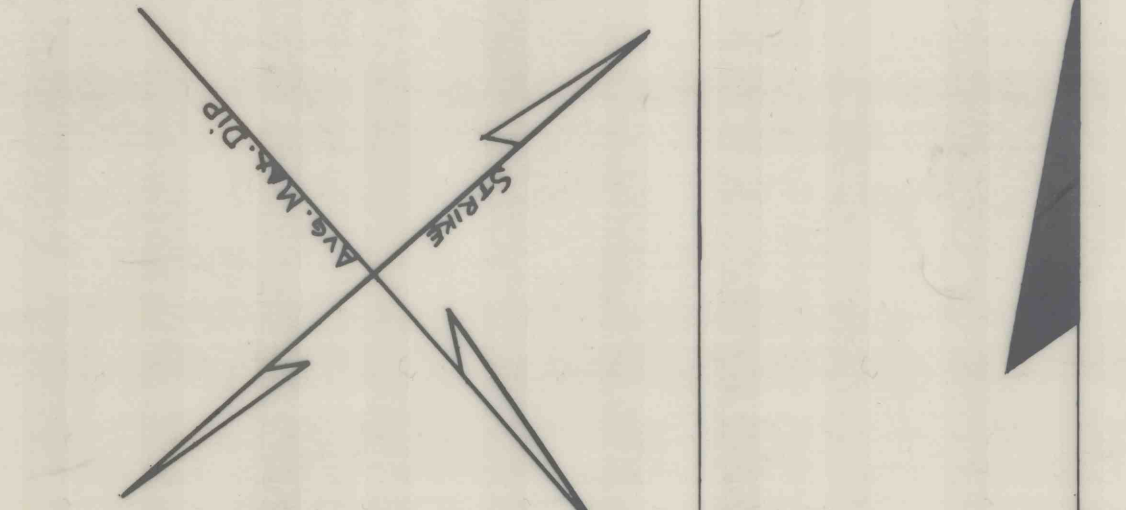

JAMISON NO. 1  
 WESTMORELAND CO.  
 SALINA, PA.  
 SCALE: 1" = 500'  
 MAIN OFFICE: 111 N. MAIN ST. GREENSBURG, PA.



REVISIONS:  
 JULY 22, 1965  
 AUG. 27, 1965



KISKIMINETAS RIVER

LOVALHANA TWP  
 BELL TWP

LOVALHANA TWP  
 BELL TWP

BELL TWP  
 LOVALHANA TWP

