


4259

52.05
11-11-25
3-8

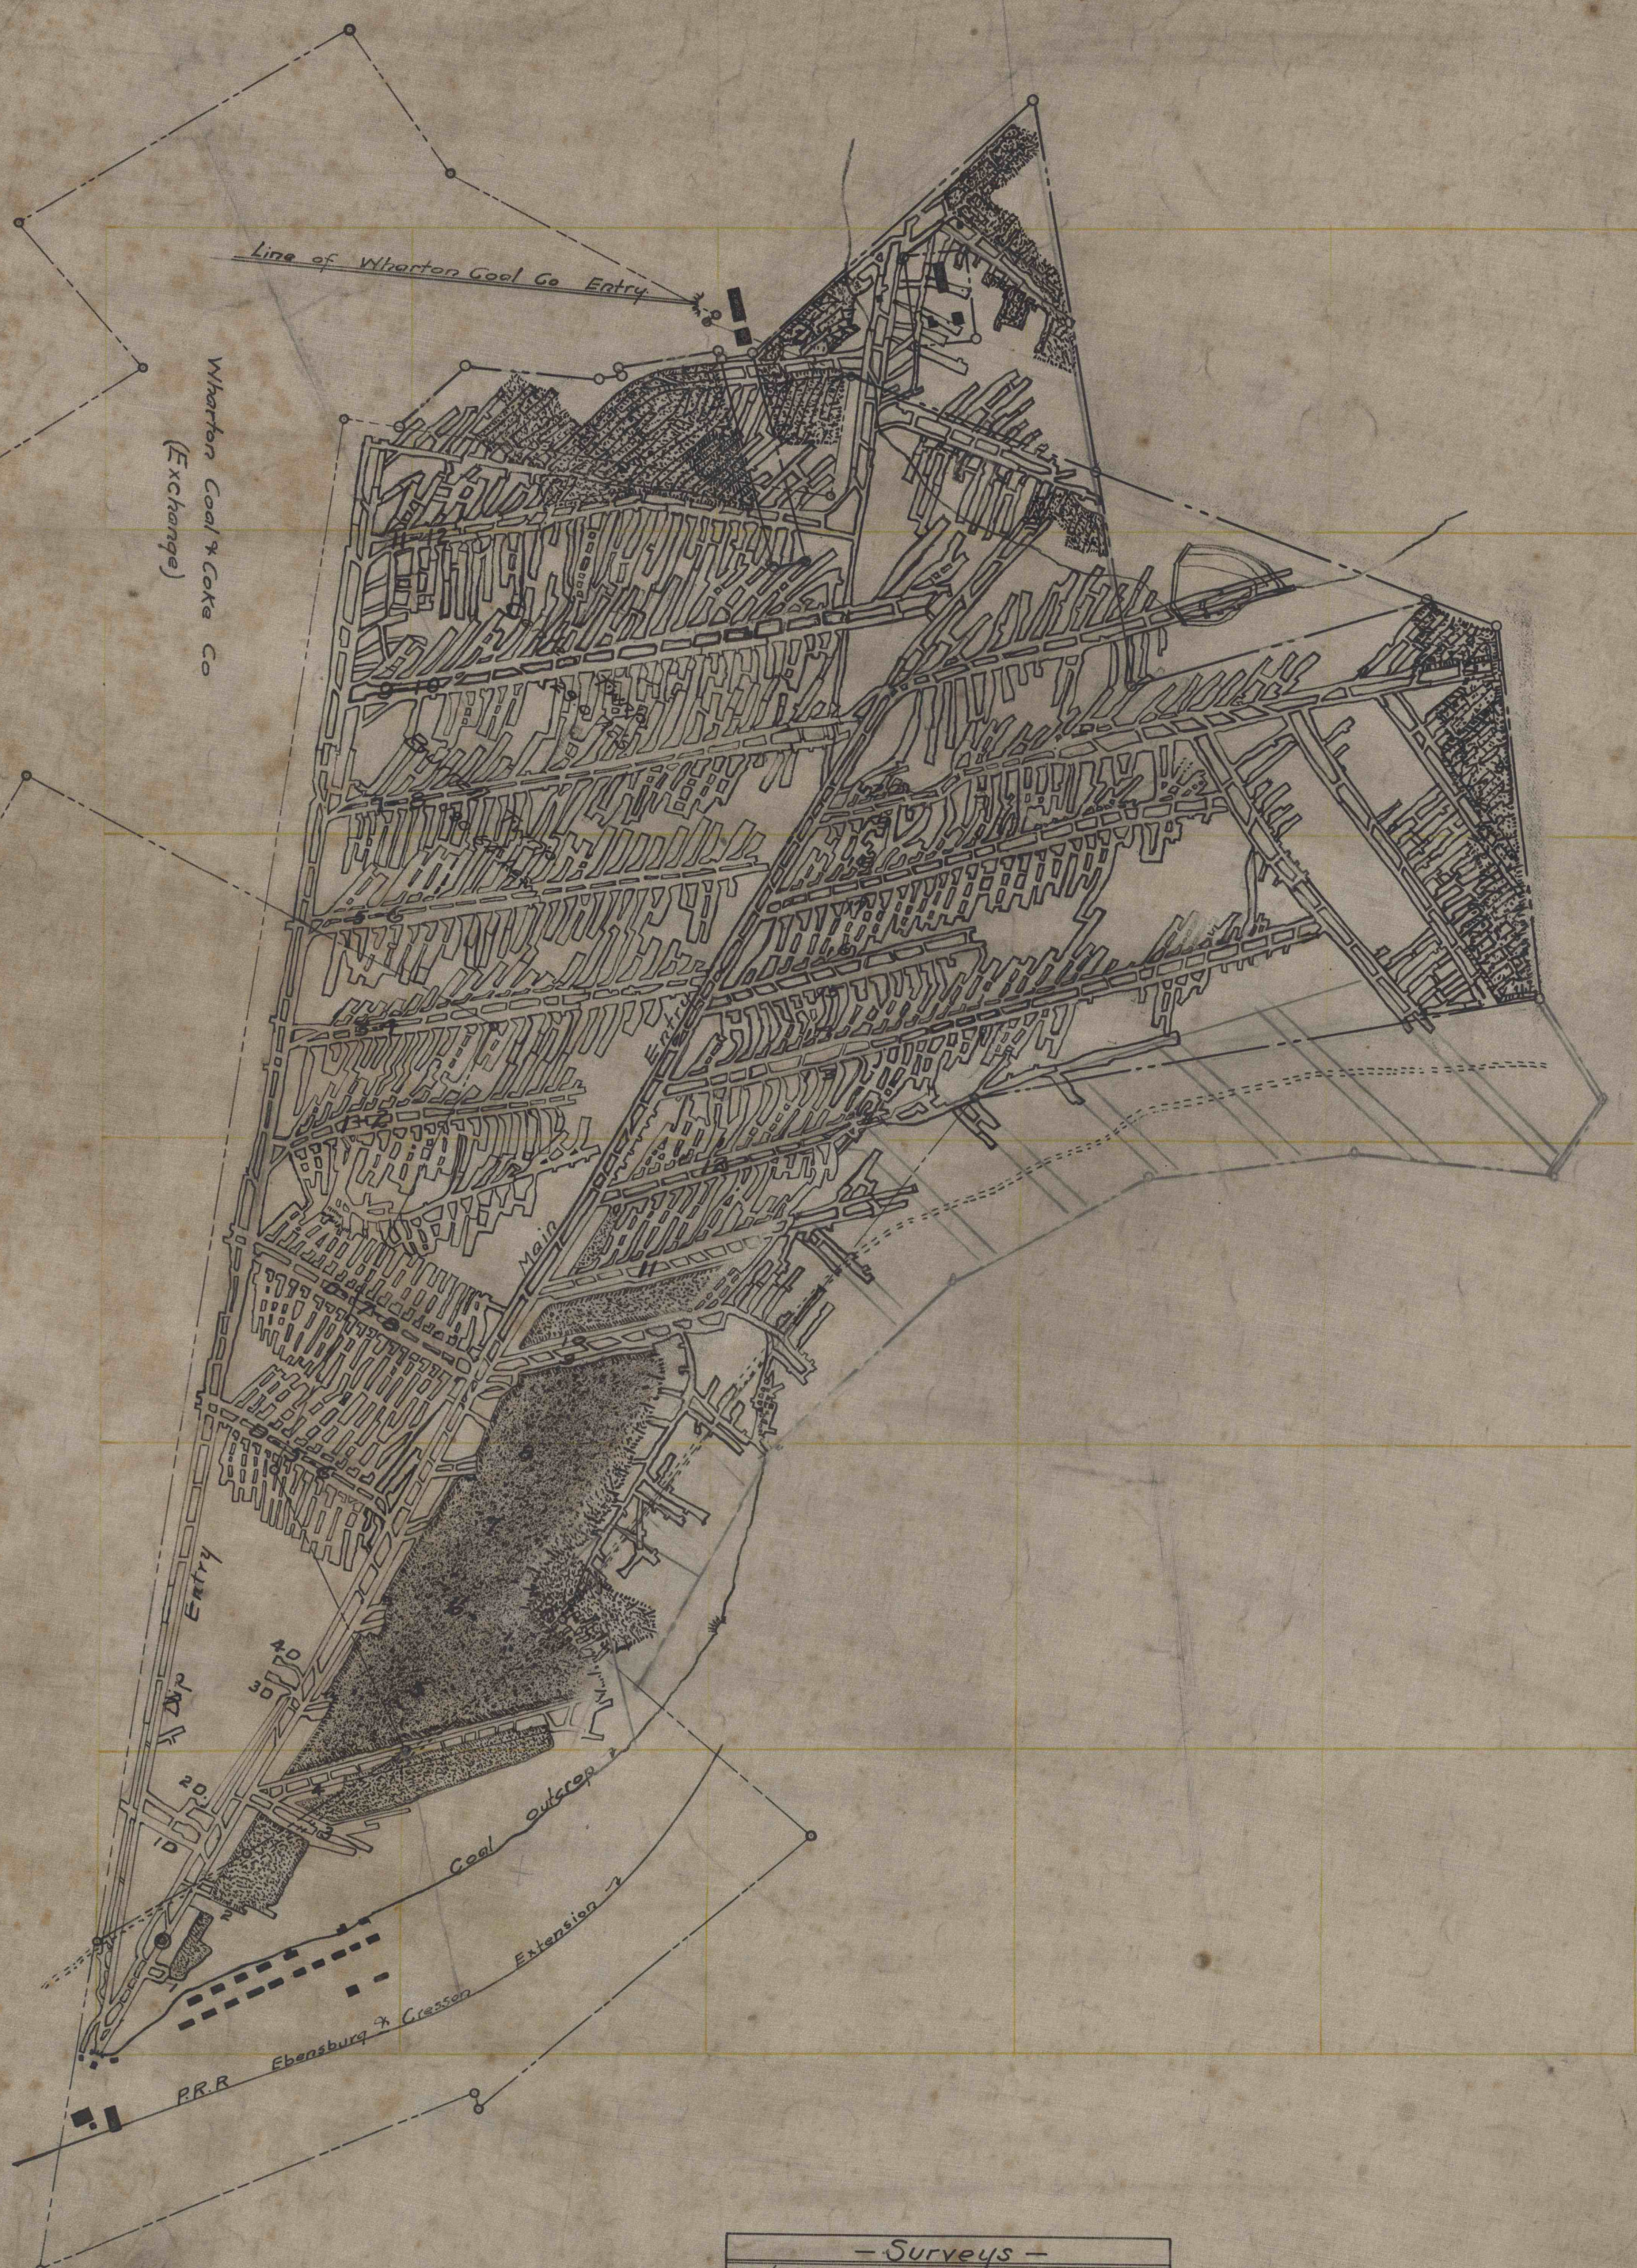

- Surveys -

Feb. 3 - 1904	to June 20 - 1916
Dec. 15 - 1916	Oct. 16, 1922
JUNE 30 - 1917	Dec. 10, 1923
OCT. 26 - 1918	Dec. 16, 1924
Oct. 24, 1919	May 26, 1925
June 21, 1920	Nov. 5, 1925
March 23, 1921	May 24, 1926
Sept. 26, 1921	Oct. 9, 1926
April 6 1927	

- SURFACE
- COAL

Mine Map
 Bells Mill Coal Co.
 Scale 1"=500' 3-8-1915.
 Albert Smith-C.E.