


Coal Lands East of Dixon Run Indiana County

scale - 1" = 500'

- LEGEND**
- CLEARFIELD BITUMINOUS COAL CORP.
 - PENNA. COAL & COKE CORP. - LEASED FROM C. B. G. CORP.
 - PIONEER COAL COMPANY
 - DIXON COAL COMPANY
 - PLEASANT VALLEY COAL COMPANY (P. PEASE)
 - UNSOLD

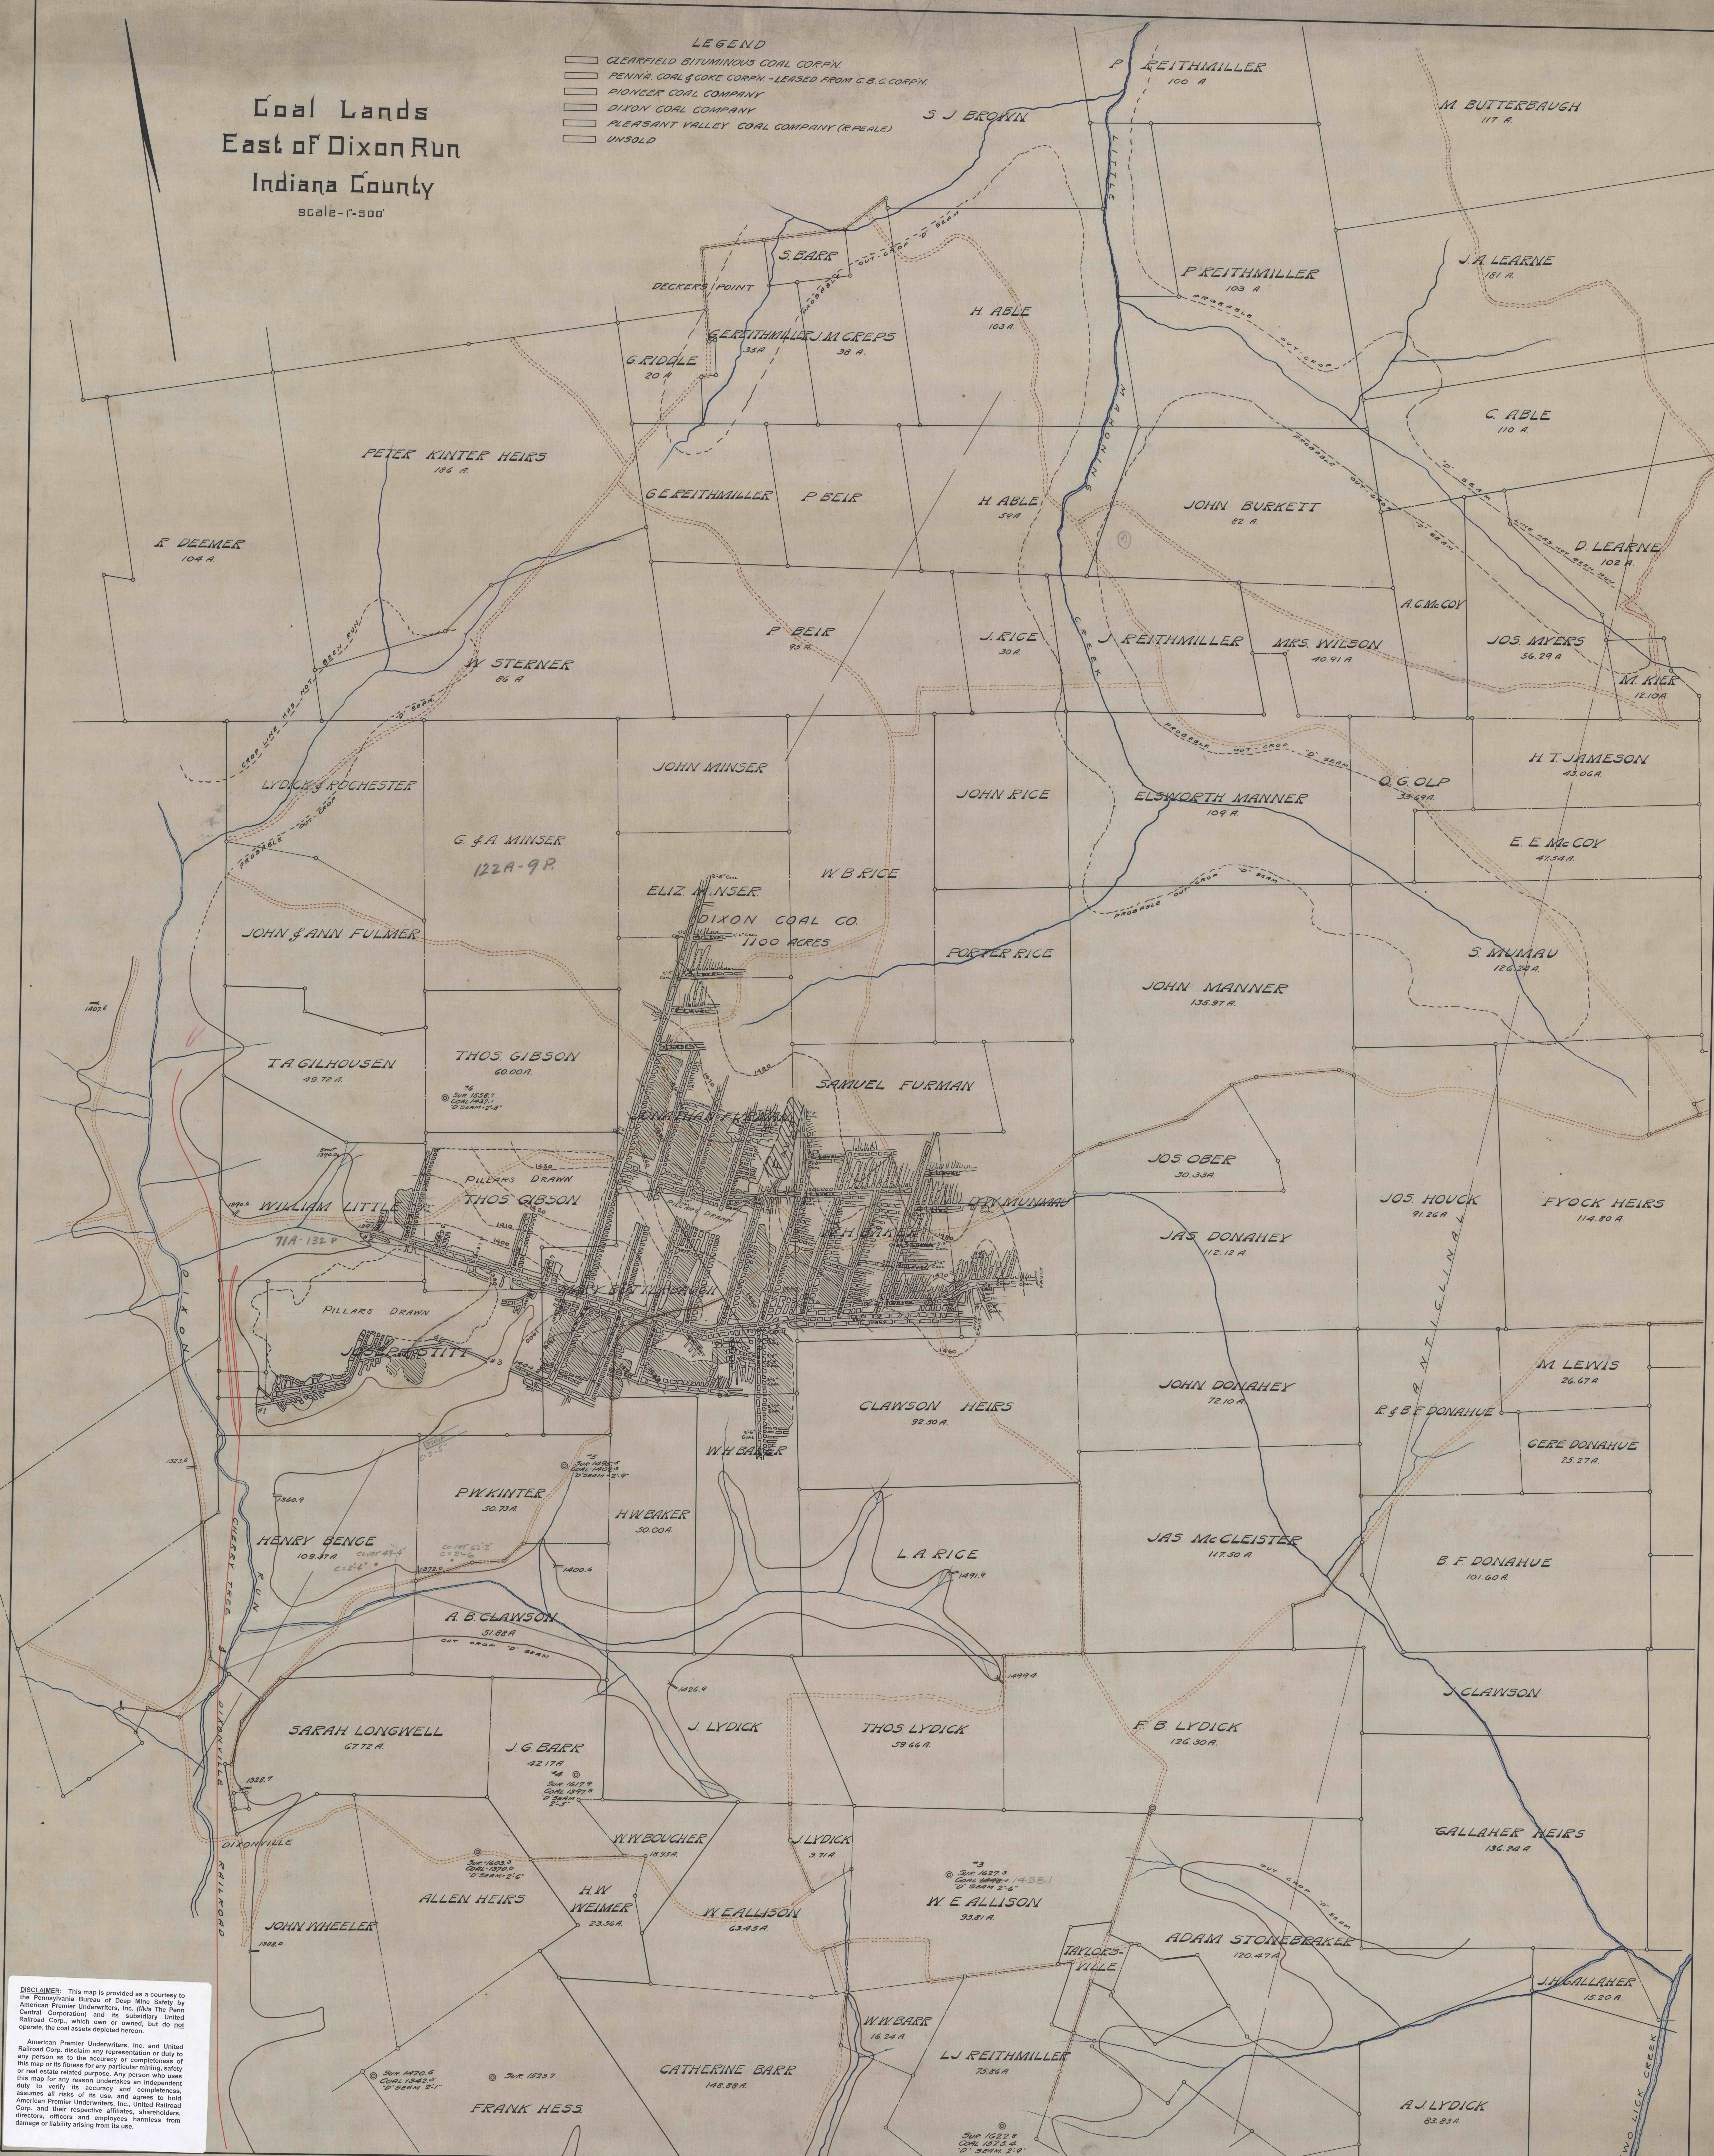

DISCLAIMER: This map is provided as a courtesy to the Pennsylvania Bureau of Deep Mine Safety by American Premier Underwriters, Inc. (aka The Penn Central Corporation) and its subsidiary United Railroad Corp., which own or owned, but do not operate, the coal assets depicted herein.

American Premier Underwriters, Inc. and United Railroad Corp. disclaim any representation or duty to any person as to the accuracy or completeness of this map or its fitness for any particular mining, safety or real estate related purpose. Any person who uses this map for any reason undertakes an independent assumption of all risks of its use, and agrees to hold American Premier Underwriters, Inc., United Railroad Corp. and their respective affiliates, shareholders, directors, officers and employees harmless from damage or liability arising from its use.