

U.S.G.S.
B.M. ON R.F. BRIDGE
1260.19

MARION CENTER

MAP OF LANDS

EAST MAHONING & RAYNE TOWNSHIP
INDIANA COUNTY, PA.


Scale 1" = 500' — Andrew B. Cristler, Esq. — March 2nd 1907

BROWN - LINES ADDED - M.C.G.M.CO.

4
3

NOTE - HOLES M1 - ETC. IN BLACK.
OUR DRILLING & LOCATIONS
E.L. BASED ON U.S.G.S. B.M. 1260.19

EAST MAHONING
RAYNE

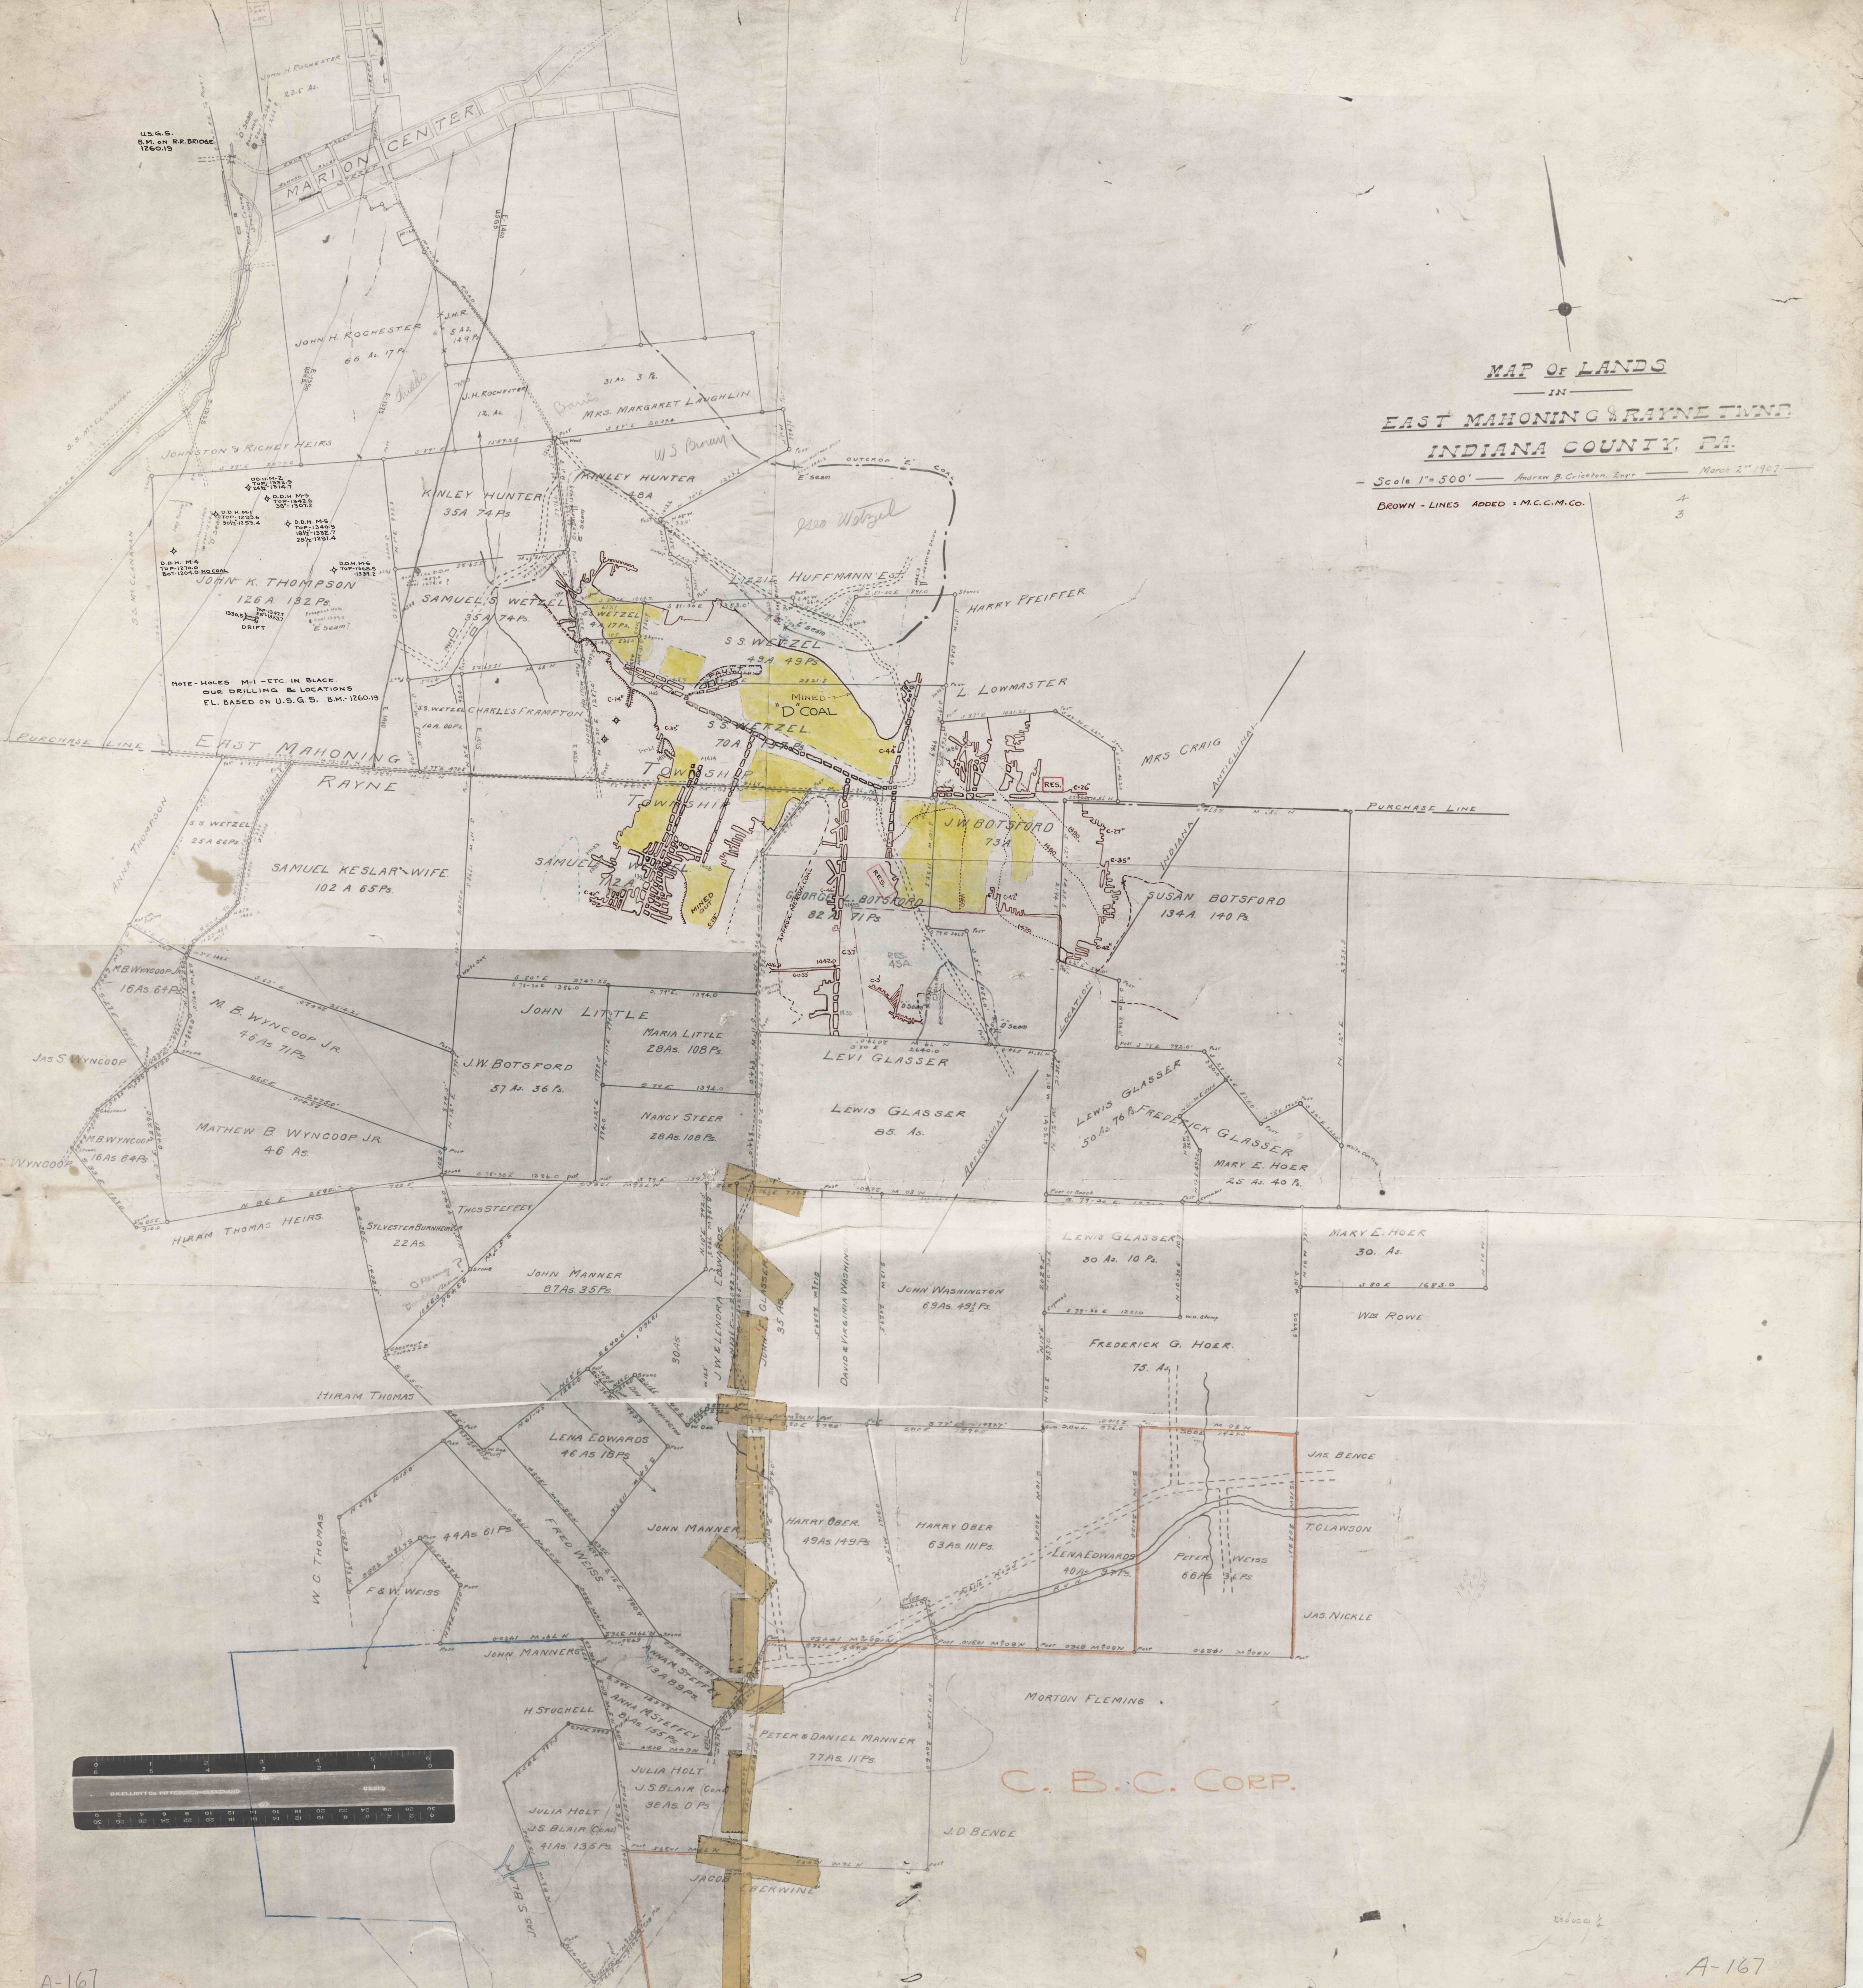

C. B. C. CORP.