


MAP OF LANDS
OF THE
CLEARFIELD BITUMINOUS COAL CORP'N.
CLYMER FIELD
INDIANA COUNTY, PA.
SCALE - 1" = 500' JULY 1917.
REVISED TO NOV. 2, 1956
Paul Hill
CH. ENGINEER

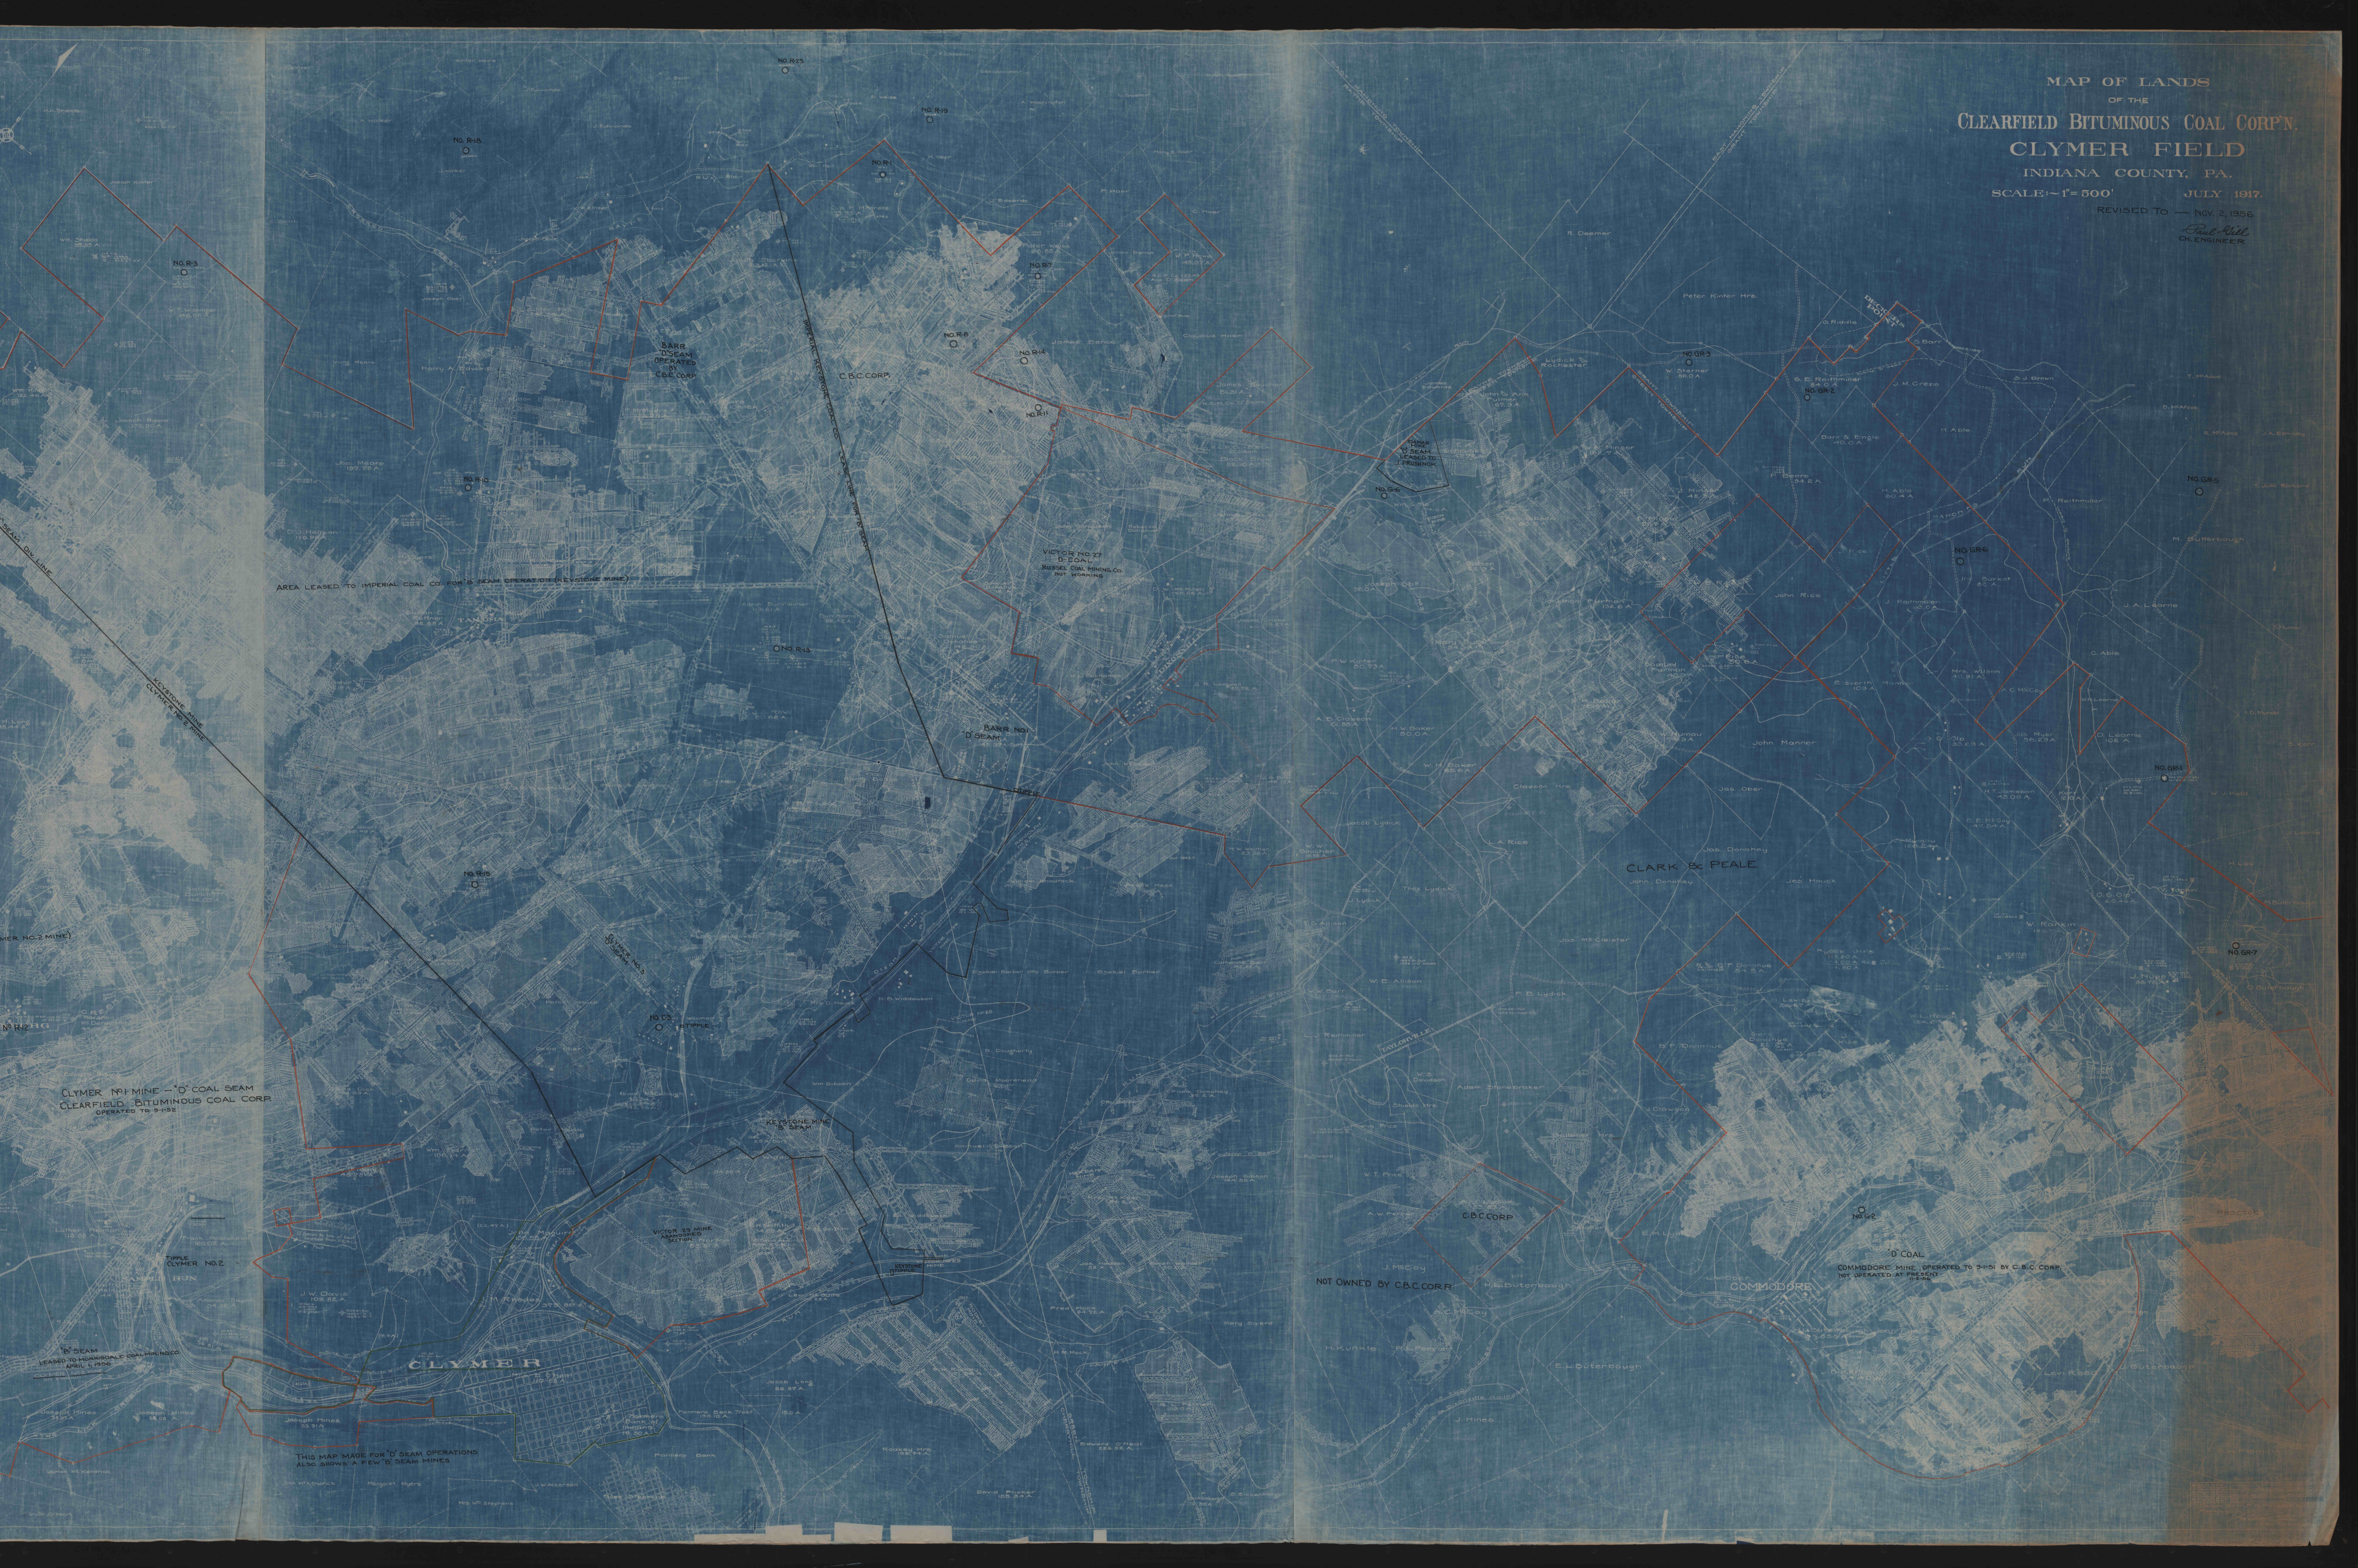

AREA LEASED TO IMPERIAL COAL CO. FOR 'B' SEAM OPERATION (KEYSTONE MINE)

BARR 'D' SEAM
OPERATED BY
C.B.C. CORP.

VICTOR 'D' SEAM
OPERATED BY
RUSSELL COAL MINING CO.
NOT WORKING

BARR 'NO. 10'
'D' SEAM

CLARK & PEALE

CLYMER 'NO. 1' MINE - 'D' COAL SEAM
CLEARFIELD BITUMINOUS COAL CORP.
OPERATED TO 9-1-52

VICTOR 'B' MINE
UNDEVELOPED
SECTION

KEYSTONE MINE
'B' SEAM

C.B.C. CORP.

NOT OWNED BY C.B.C. CORP.

COMMODORE

'D' COAL
COMMODORE MINE, OPERATED TO 3-1-51 BY C.B.C. CORP.
NOT OPERATED AT PRESENT

THIS MAP MADE FOR 'D' SEAM OPERATIONS
ALSO SHOWS A FEW 'B' SEAM MINES