


CLYMER FIELD  
INDIANA COUNTY, PA.  
SCALE: 1"=500' JULY 1917.

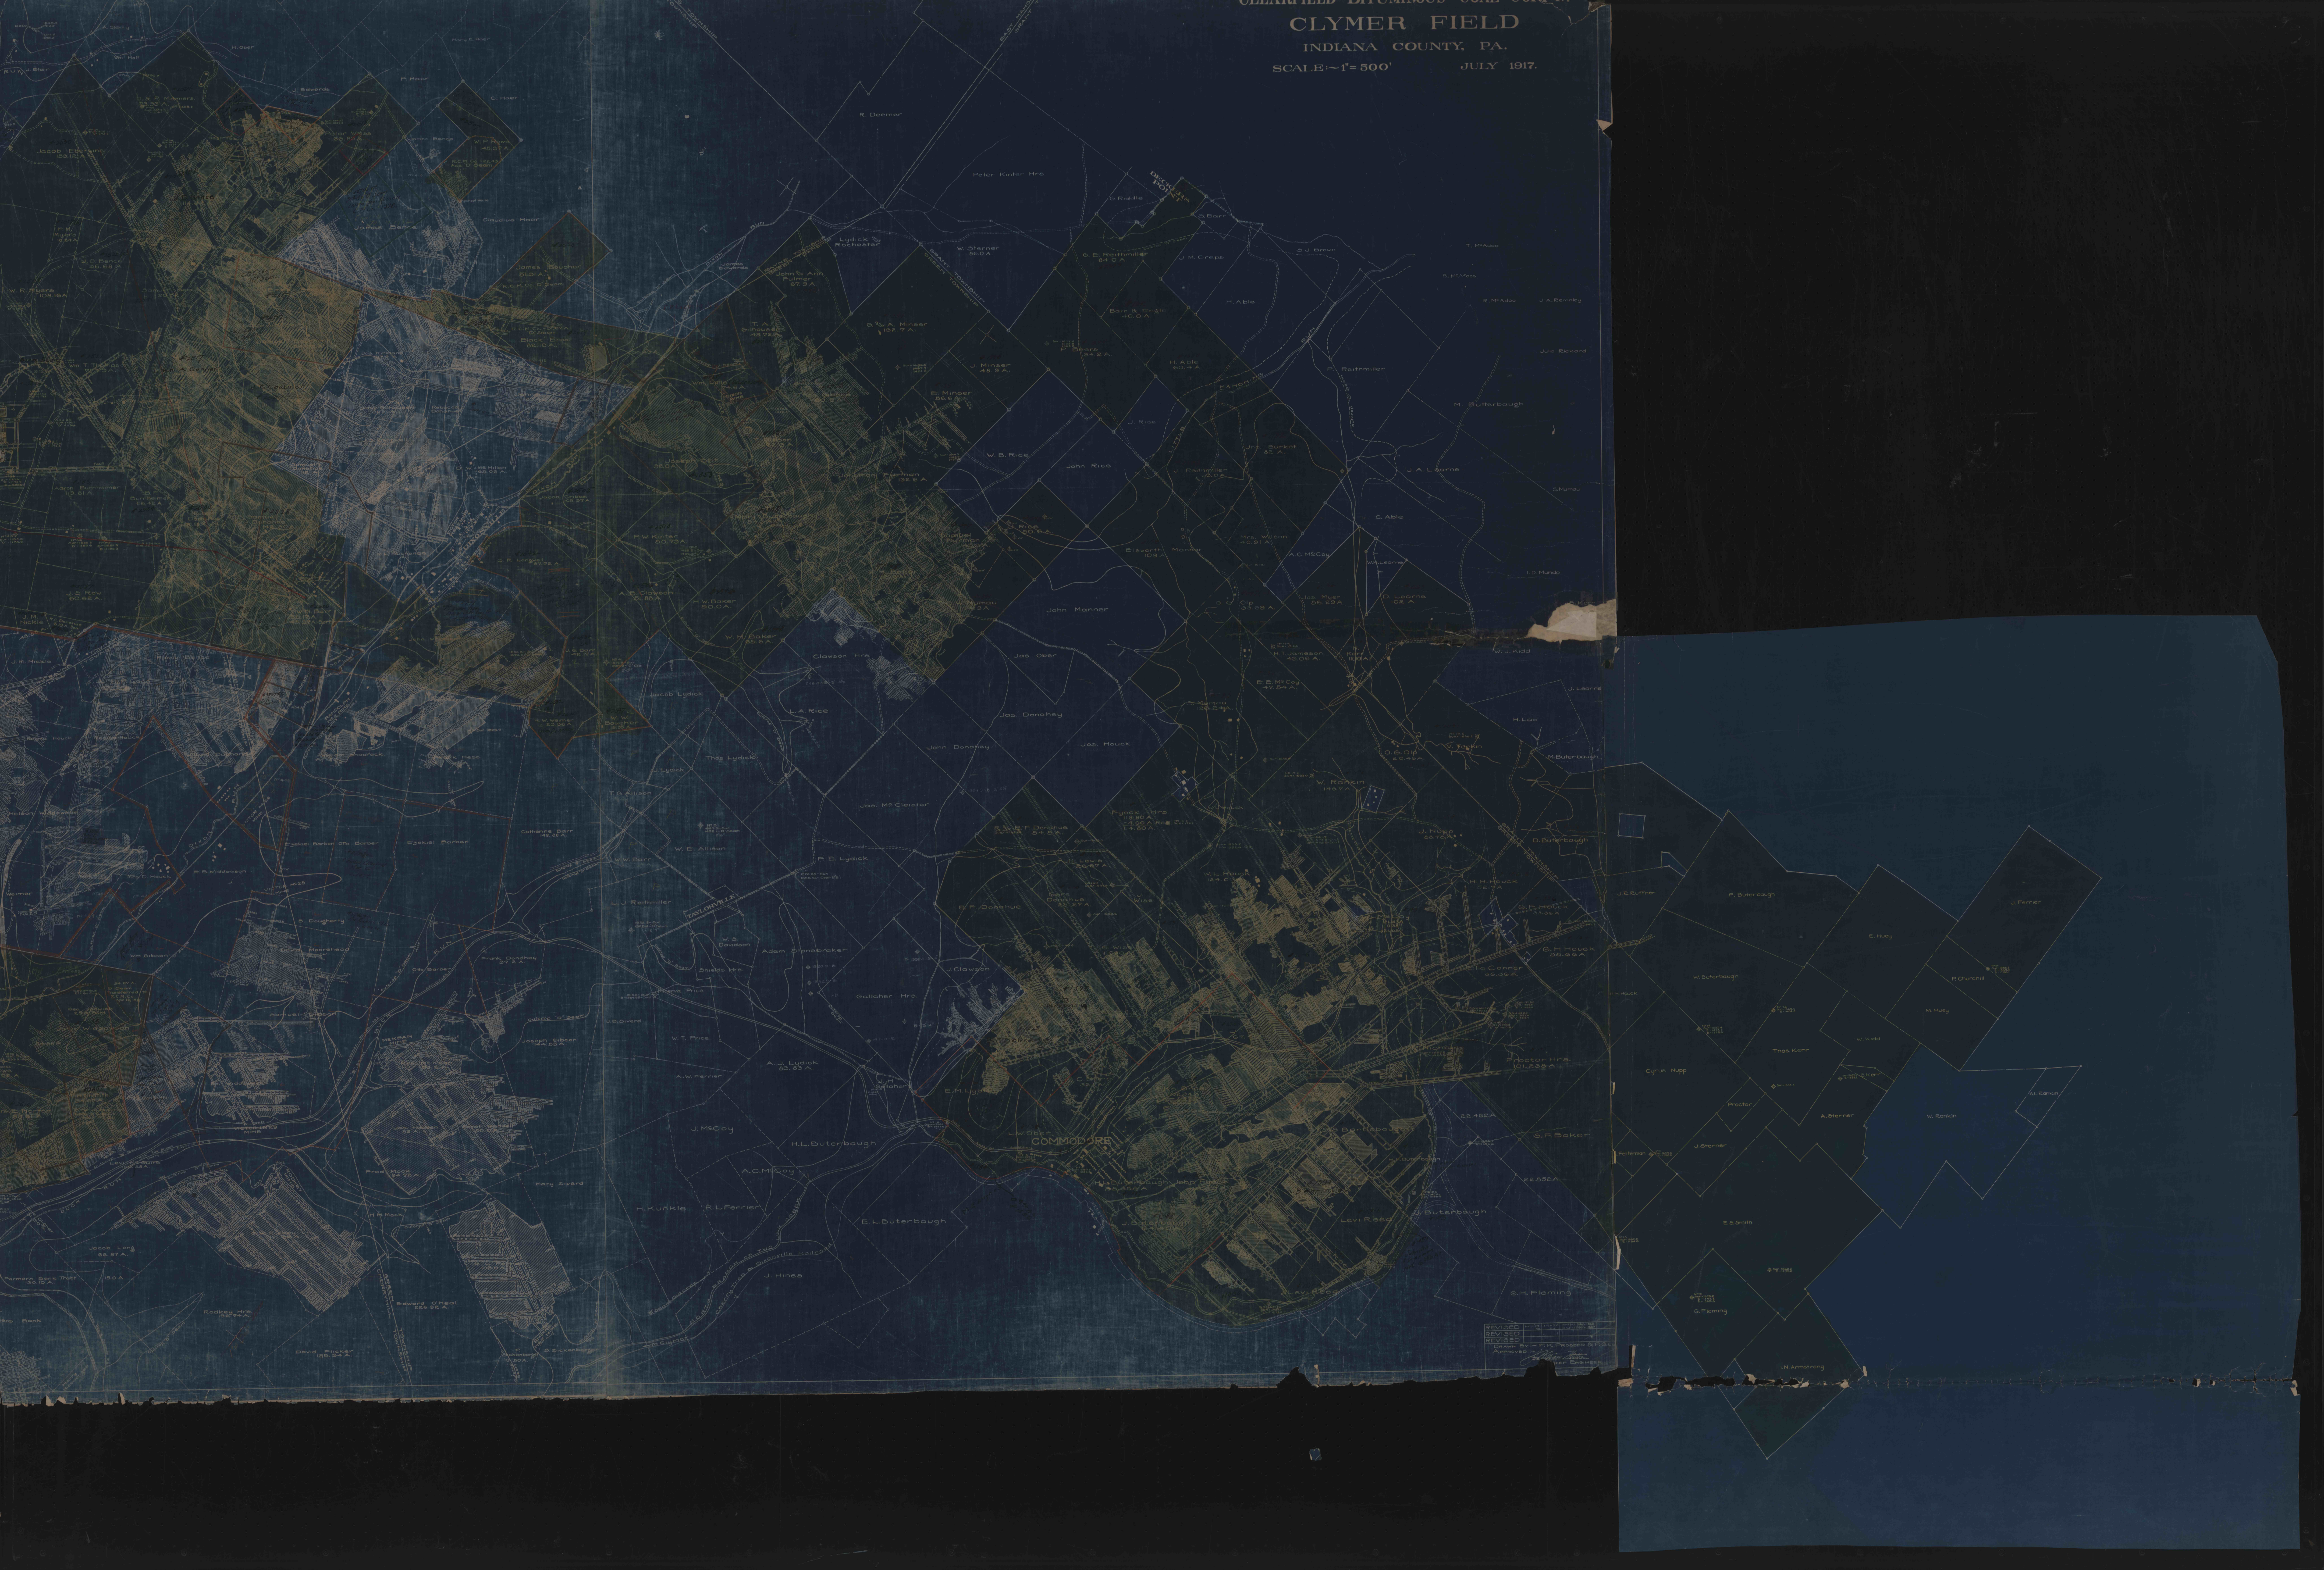

REVISED  
BY  
REVISED  
BY  
REVISED  
BY