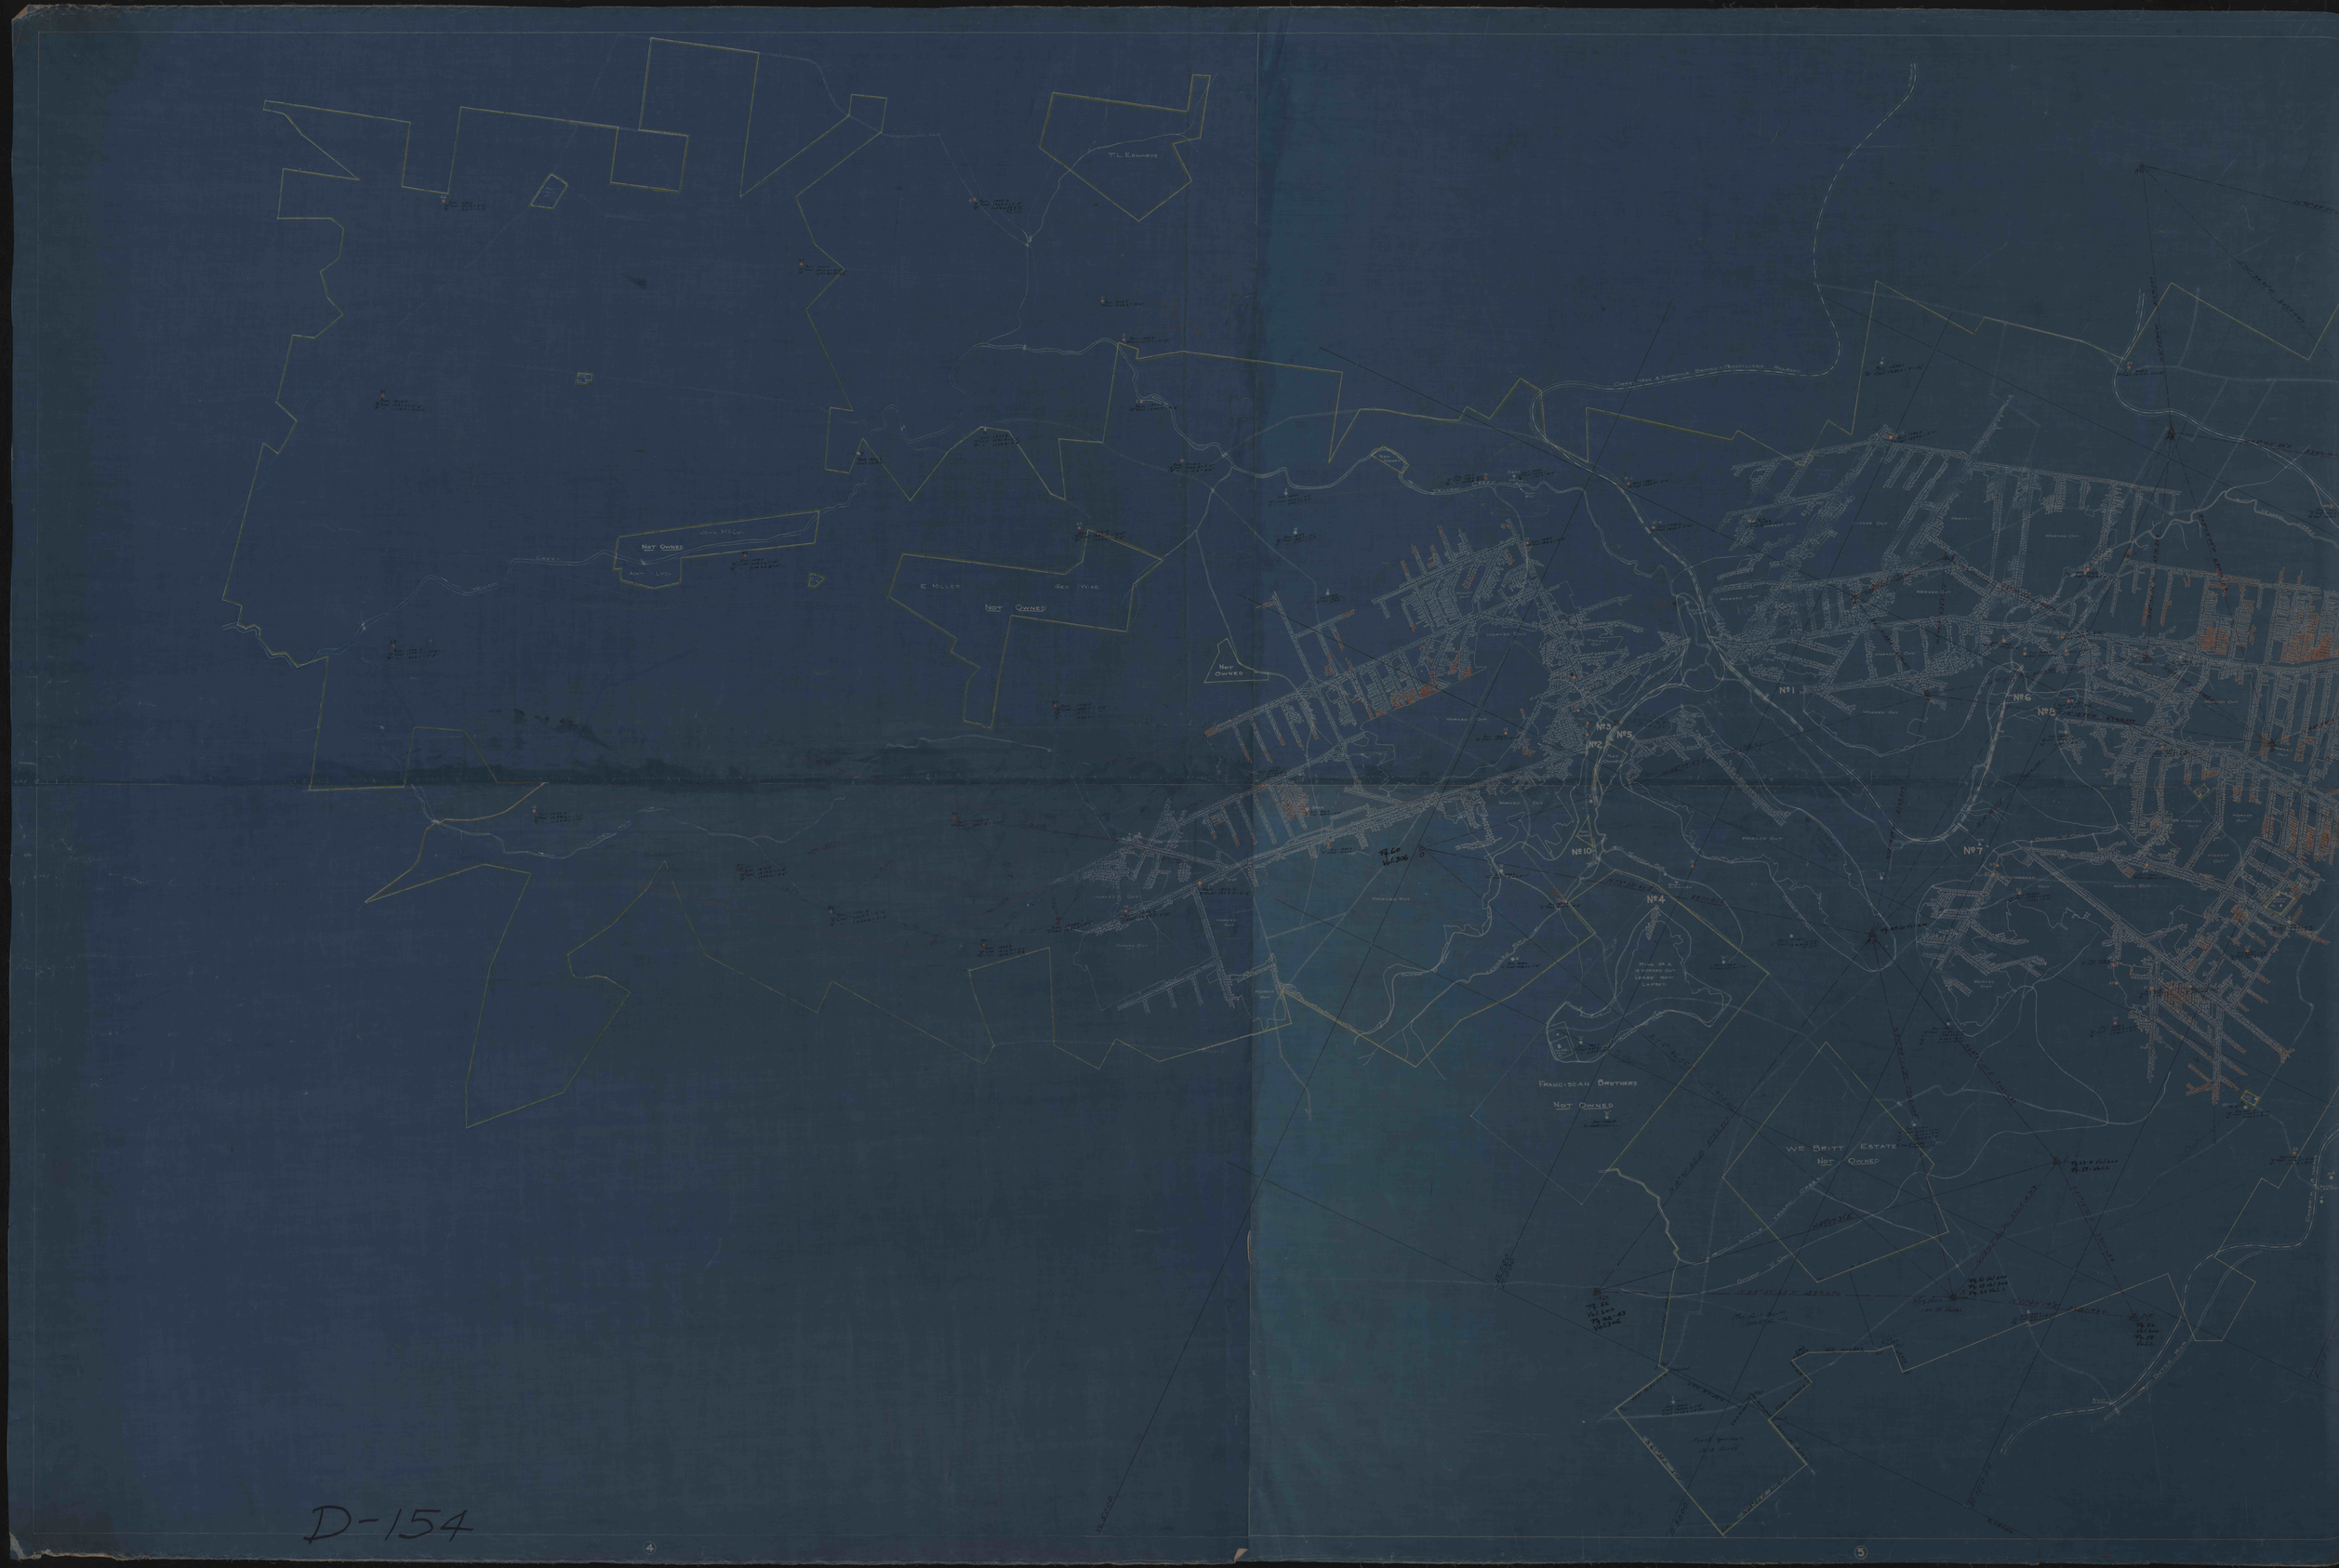
T.L. Edwards
Not Owned
E. Miller Est. Wife
Not Owned
Not Owned
No 1
No 2
No 3
No 5
No 6
No 8
No 10
No 7
No 4
Franciscan Brothers
Not Owned
W.S. Britt Estate
Not Owned

D-154