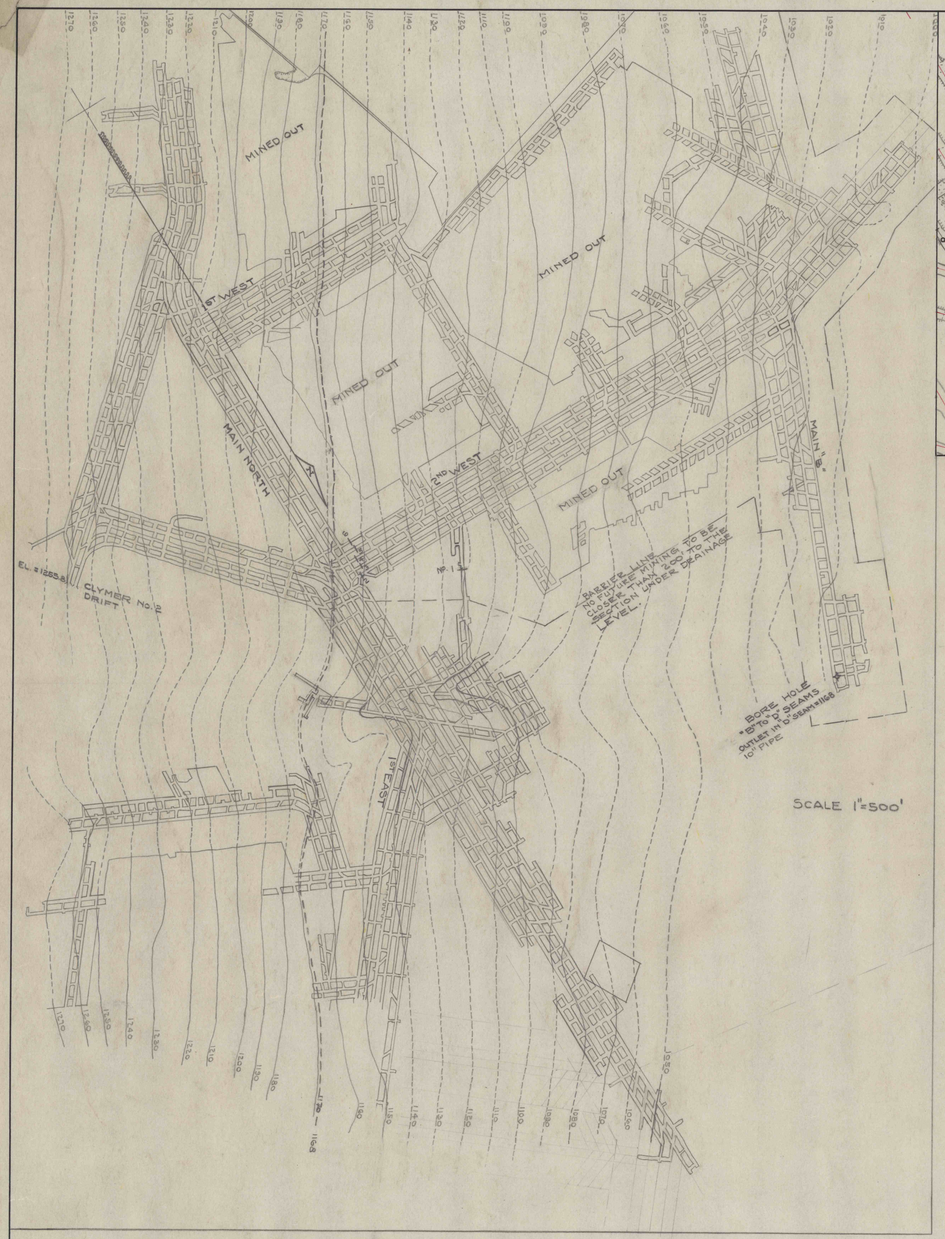

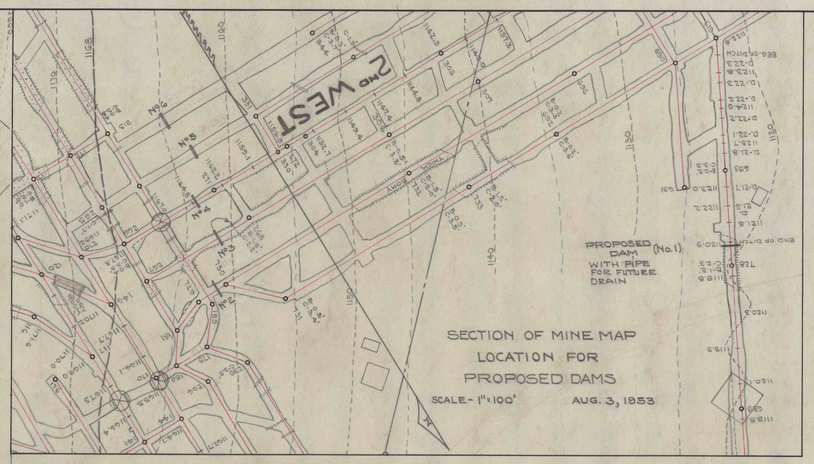

ALL CHANNELS OR HITCHES TO BE MADE WITHOUT BLASTING.

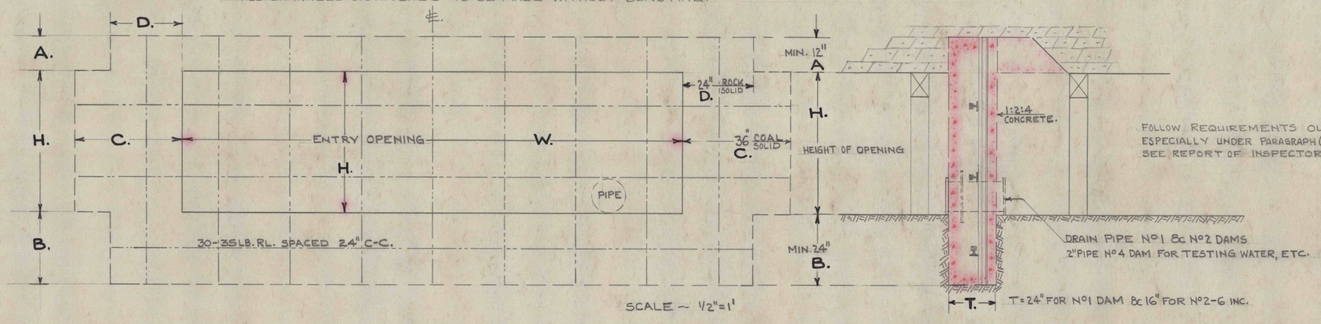

FOLLOW REQUIREMENTS OUTLINED BY COMMISSION, ESPECIALLY UNDER PARAGRAPH (7) "REQUIREMENTS". SEE REPORT OF INSPECTOR'S COMMISSION 9-2-53

DRAIN PIPE No 1 & No 2 DAMS
2" PIPE No 4 DAM FOR TESTING WATER, ETC.

ELEVATION - SECTION FOR DAMS AS REQUIRED BY COMMISSION OF 3 BIT. MINE INSPECTORS

under CONSTRUCTION
JAN-MAR. 1955

DISCLAIMER. This map is provided as a courtesy to the Pennsylvania Bureau of Deep Mine Safety by American Premier Underwriters, Inc. (f/k/a The Penn Central Railroad Corporation) and its subsidiary United Railroad Corp., which own or owned, but do not operate, the coal assets depicted hereon.

American Premier Underwriters, Inc. and United Railroad Corp. disclaim any representation or duty to any person as to the accuracy or completeness of this map or its fitness for any particular mining, safety or real estate related purpose. Any person who uses this map for any reason undertakes an independent duty to verify its accuracy and completeness, assumes all risks of its use, and agrees to hold American Premier Underwriters, Inc., United Railroad Corp. and their respective affiliates, shareholders, directors, officers and employees harmless from damage or liability arising from its use.

PROPOSED DAMS
2ND WEST ENTRIES
CLYMER No 2 MINE
CHERRYHILL TWP, INDIANA CO. PA.
SCALE - AS SHOWN AUG. 5 1953

ENGINEERING DEPARTMENT
CLEARFIELD BITUMINOUS COAL CORP.

REVISED	8-31-54	2-9-55				

PLAN - COMM. - P.G. DRAWN -
TRACED - CHECKED -

Paul Gill
ENGINEER

2-9-55 FOR J.D. LEADBETTER TO MAKE PERMANENT RECORD
KEEP ONE PRINT FOR ALL RECORDS OF DAMS - SKETCH SIZES WITH HITCHES DETAILED AS TO DIMENSIONS, MATERIALS USED, ETC.

VENTILATION DRAWER