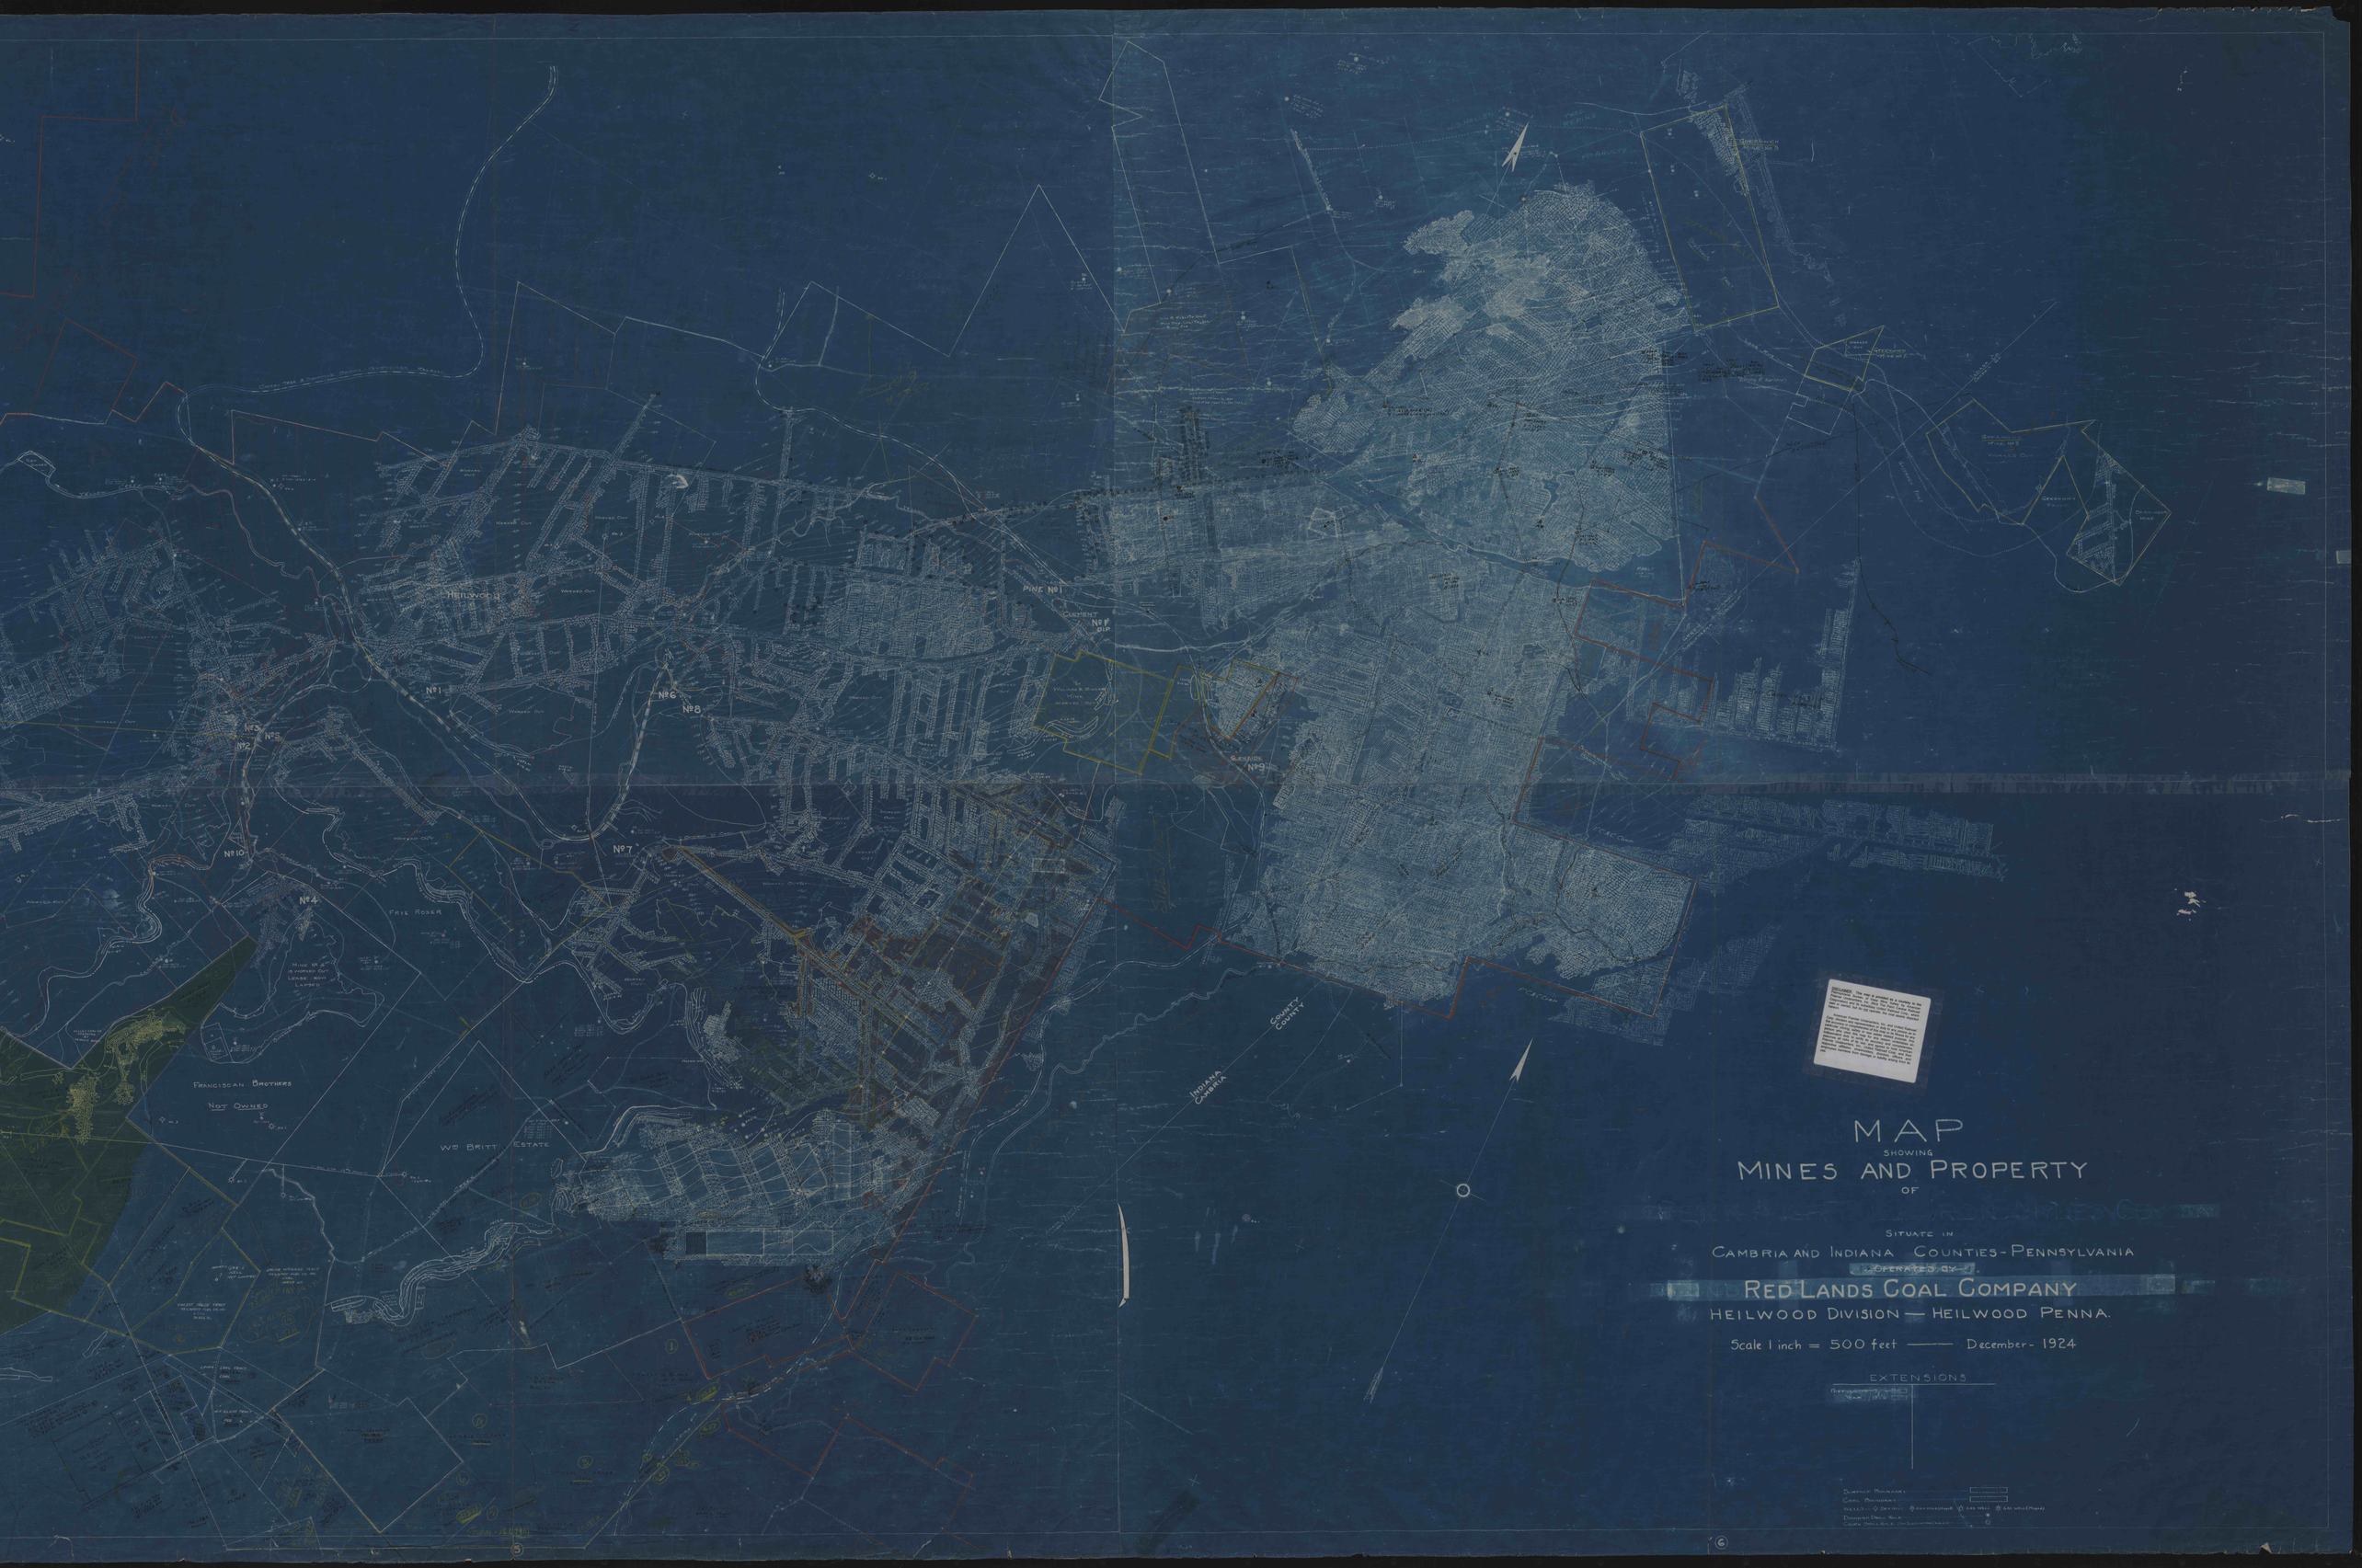
MAP
SHOWING
MINES AND PROPERTY
OF
SITUATE IN
CAMBRIA AND INDIANA COUNTIES - PENNSYLVANIA
OPERATED BY
RED LANDS COAL COMPANY
HEILWOOD DIVISION — HEILWOOD PENNA.
Scale 1 inch = 500 feet —— December - 1924
EXTENSIONS
HEILWOOD
PINE No 1
No 1
No 2
No 3
No 4
No 5
No 6
No 7
No 8
No 9
No 10
FRYE ROSER
FRANCISCAN BROTHERS
NOT OWNED
WM BRITT ESTATE
INDIANA
CAMBRIA
COUNTY
COUNTY