
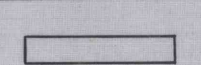
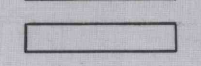
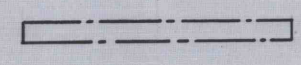


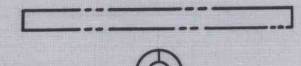


MAP
 SHOWING
MINES AND PROPERTY
 OF
BETHLEHEM CUBA IRON MINES COMPANY
 SITUATE IN
 CAMBRIA AND INDIANA COUNTIES - PENNSYLVANIA
 OPERATED BY
INDUSTRIAL COLLIERIES CORPORATION
 HEILWOOD DIVISION — HEILWOOD PENNA.
 Scale 1 inch = 500 feet — December 1924

EXTENSIONS

PREVIOUS TO 19	
YEAR 19	

SURFACE BOUNDARY	
COAL BOUNDARY	
GAS WELL	
DIAMOND DRILL HOLE	
CHURN DRILL HOLE (FOR SUBSTATION CABLES)	

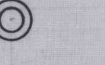