

INDEX FOR 200' BCNR MINING CORPORATION CLYDE MINE

EAST BETHELEHEM & WEST BETHELEHEM TWPS. & DEEMSTON BORO.

WASHINGTON COUNTY PA.

MORGAN-JEFFERSON & WASHINGTON TWPS. & CLARKSVILLE BORO.

GREENE COUNTY PA.



DATE OF SURVEY 11-15-81 SCALE 1" = 500'

LEGEND

MINERAL BOUNDARY LINES

CO. & TWP. BOUNDARY LINES

1" = 200' SHEET LAYOUT

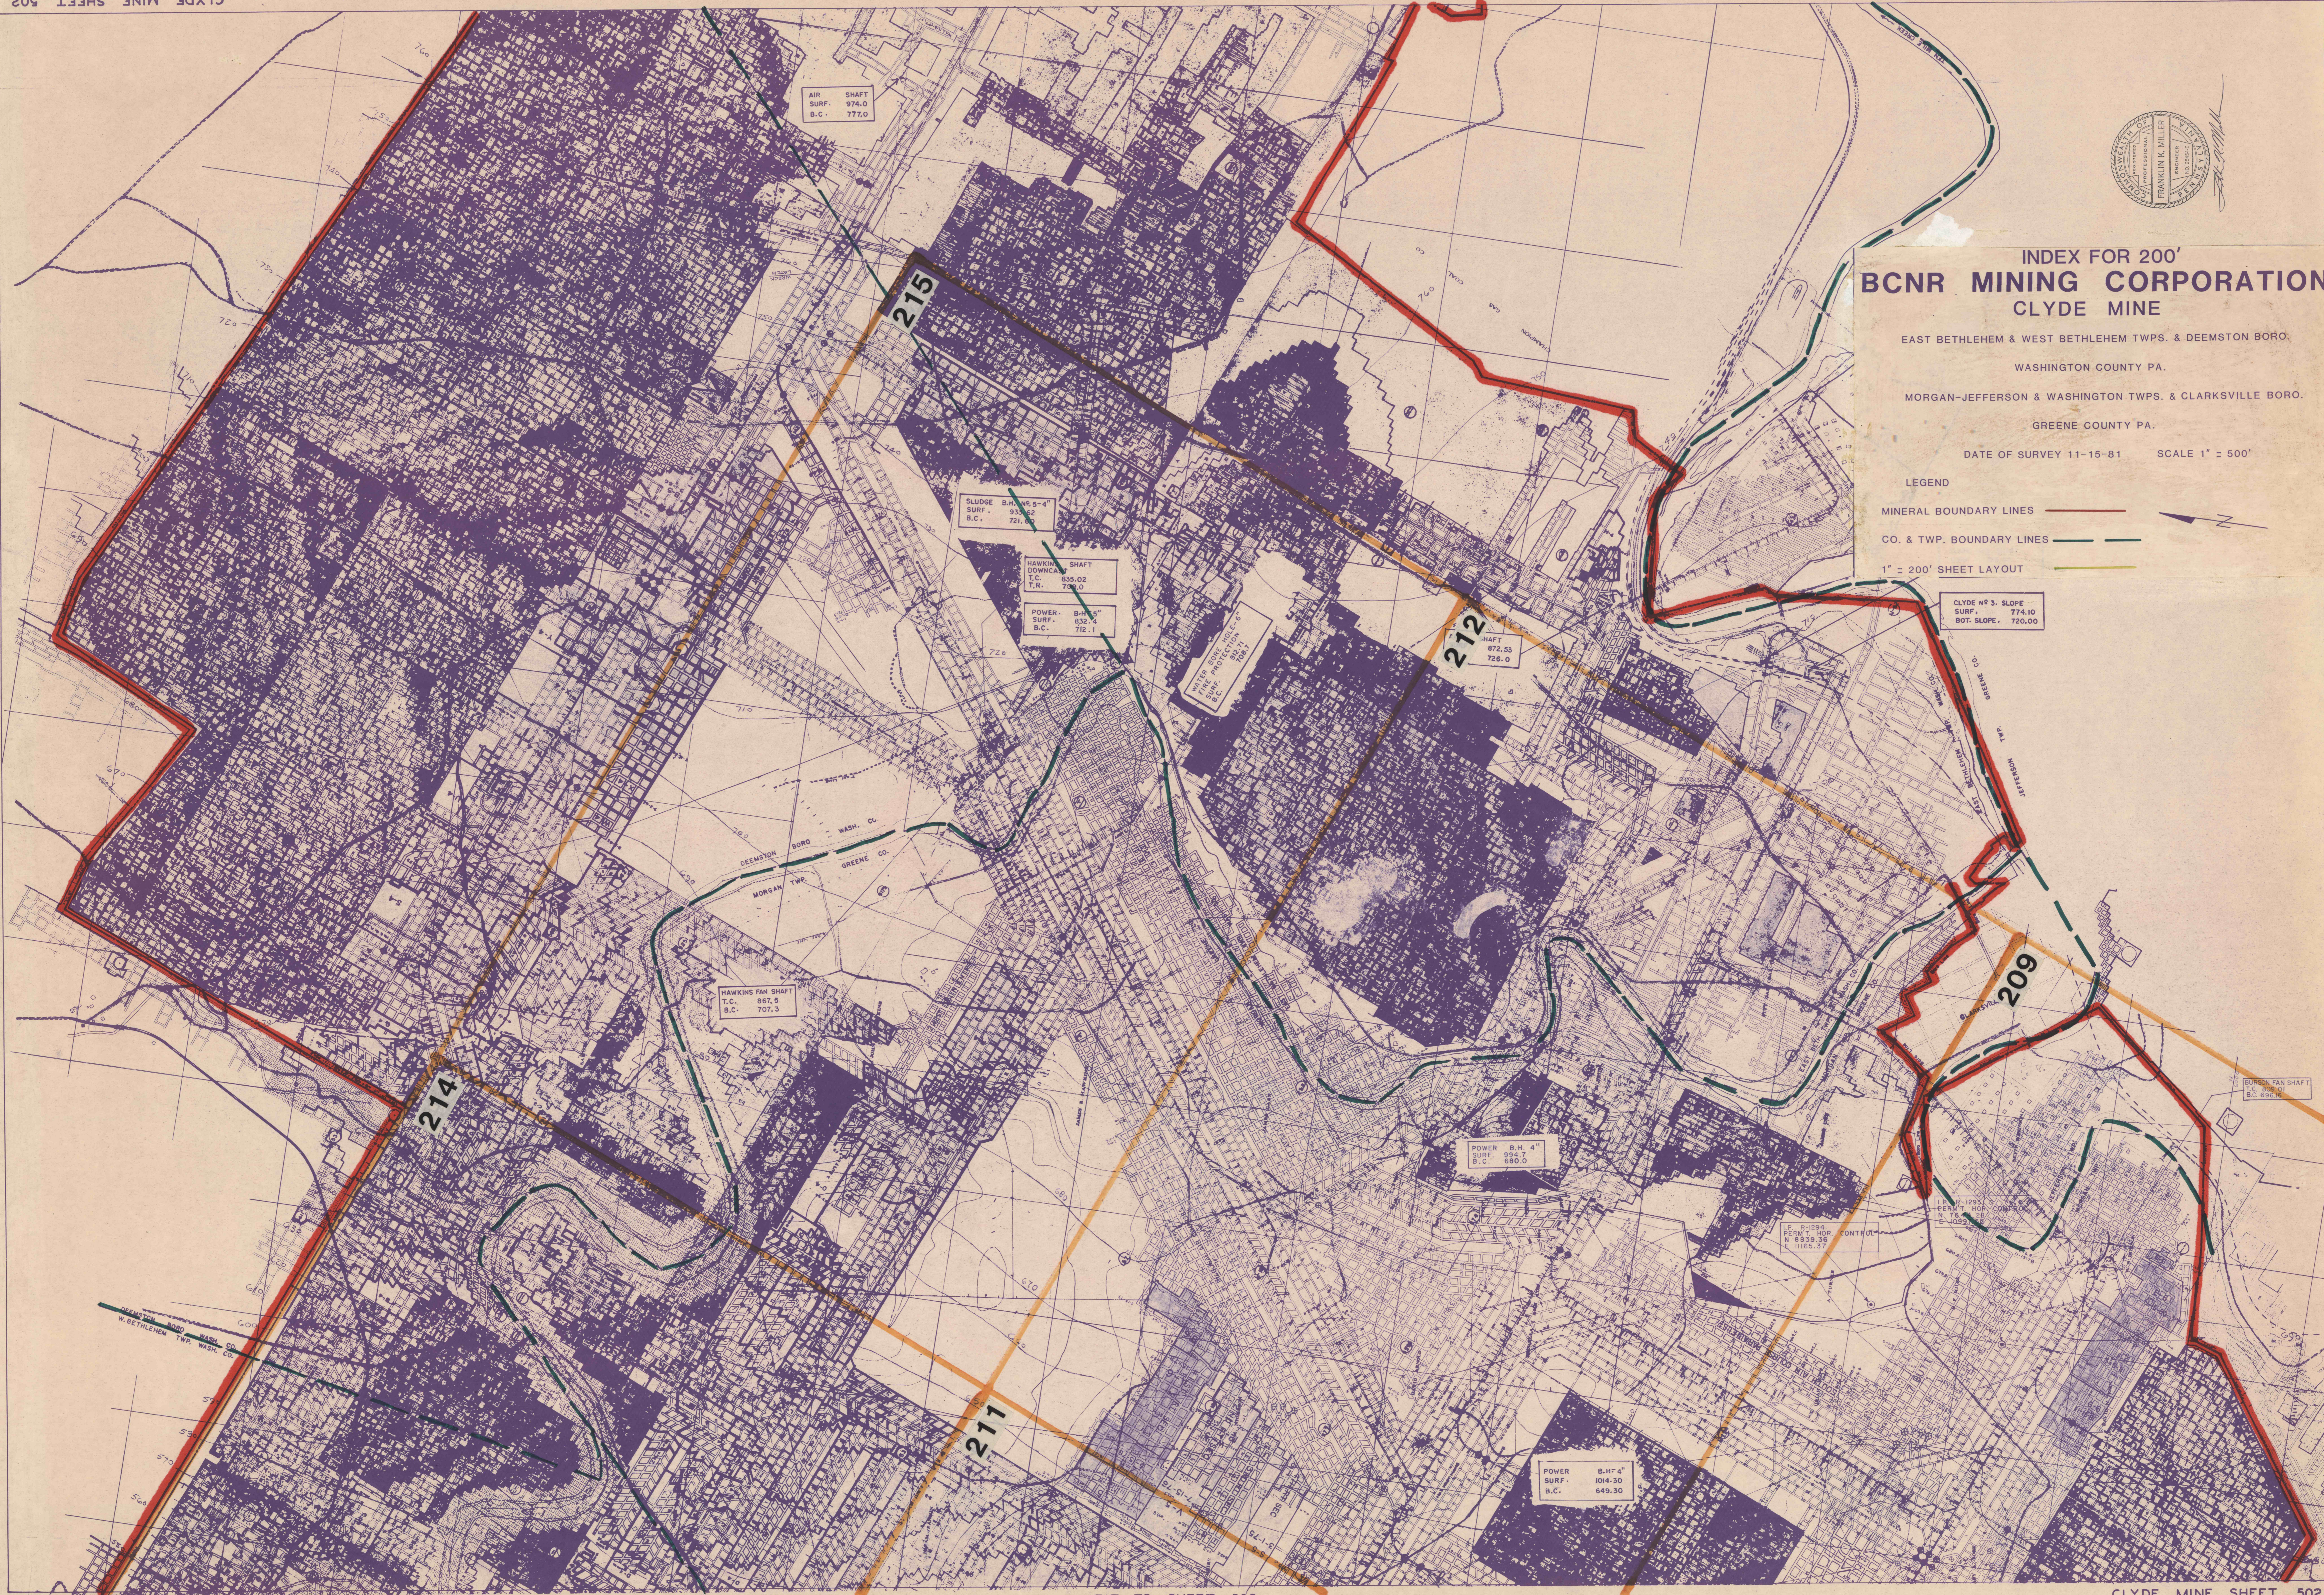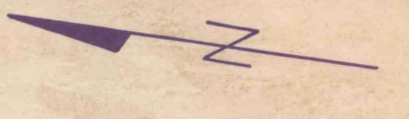

AIR SHAFT
SURF. 974.0
B.C. 777.0

215

SLUDGE BANK 5-4'
SURF. 923.52
B.C. 721.00

HAWKINS SHAFT
DOWNCAST
T.C. 839.02
T.R. 730.0

POWER B.H. 5"
SURF. 832.4
B.C. 712.1

WATER BORO. INC. 14"
SLIP PROTECTION
B.C. 808.7

212

HAFT
SURF. 872.53
B.C. 726.0

CLYDE NO. 3. SLOPE
SURF. 774.10
BOT. SLOPE. 720.00

HAWKINS FAN SHAFT
T.C. 867.5
B.C. 707.3

214

POWER B.H. 4"
SURF. 884.0
B.C. 690.0

209

POWER B.H. 4"
SURF. 1044.30
B.C. 649.30

211