


NEW ZOLLARSVILLE B.H. TOP PAD. 855.67 B.C. 566.36 CASING 16"	SLUDGE B.H. N°2 SURF. 881.30 B.C. 560.00 CASING 4"
OLD ZOLLARSVILLE B.H. T.C. 89.13 B.C. 554.9 CASING 22"	SLUDGE B.H. N°1 SURF. 925.00 B.C. 562.00 CASING 4"

BETHLEHEM
MINES
CORPORATION

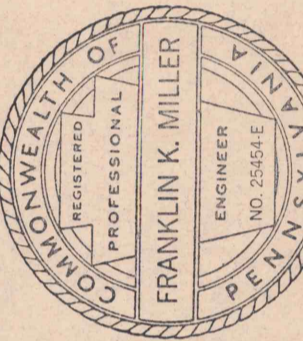

INDEX FOR 200'
BCNR MINING CORPORATION
CLYDE MINE

EAST BETHLEHEM & WEST BETHLEHEM TWP.S. & DEEMSTON BORO.
WASHINGTON COUNTY PA.
MORGAN-JEFFERSON & WASHINGTON, TWP.S. & CLARKSVILLE BORO.
GREENE COUNTY PA.

DATE OF SURVEY 11-15-81 SCALE 1" = 500'

- LEGEND
- MINERAL BOUNDARY LINES —
 - CO. & TWP. BOUNDARY LINES - - -
 - 1" = 200' SHEET LAYOUT —