


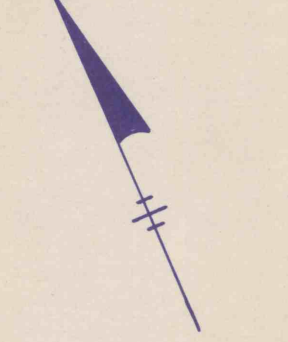

28.00 - 28.00
 51. coal - 100
 53/4 miles SE

FIT TO SHEET 502



RECEIVED
 FEB 01 1989
 Dept. of Environmental Resources
 McMurry District Office

NEWFIELD MINE
 BCNR MINING CORPORATION
 PENN HILLS TWP PLUM BORO. MONROEVILLE BORO.
 ALLEGHENY CO PA
 SCALE 1" = 500'

SURVEY EXTENDED TO 1:1888
 NEWFIELD MINE SHEET 501