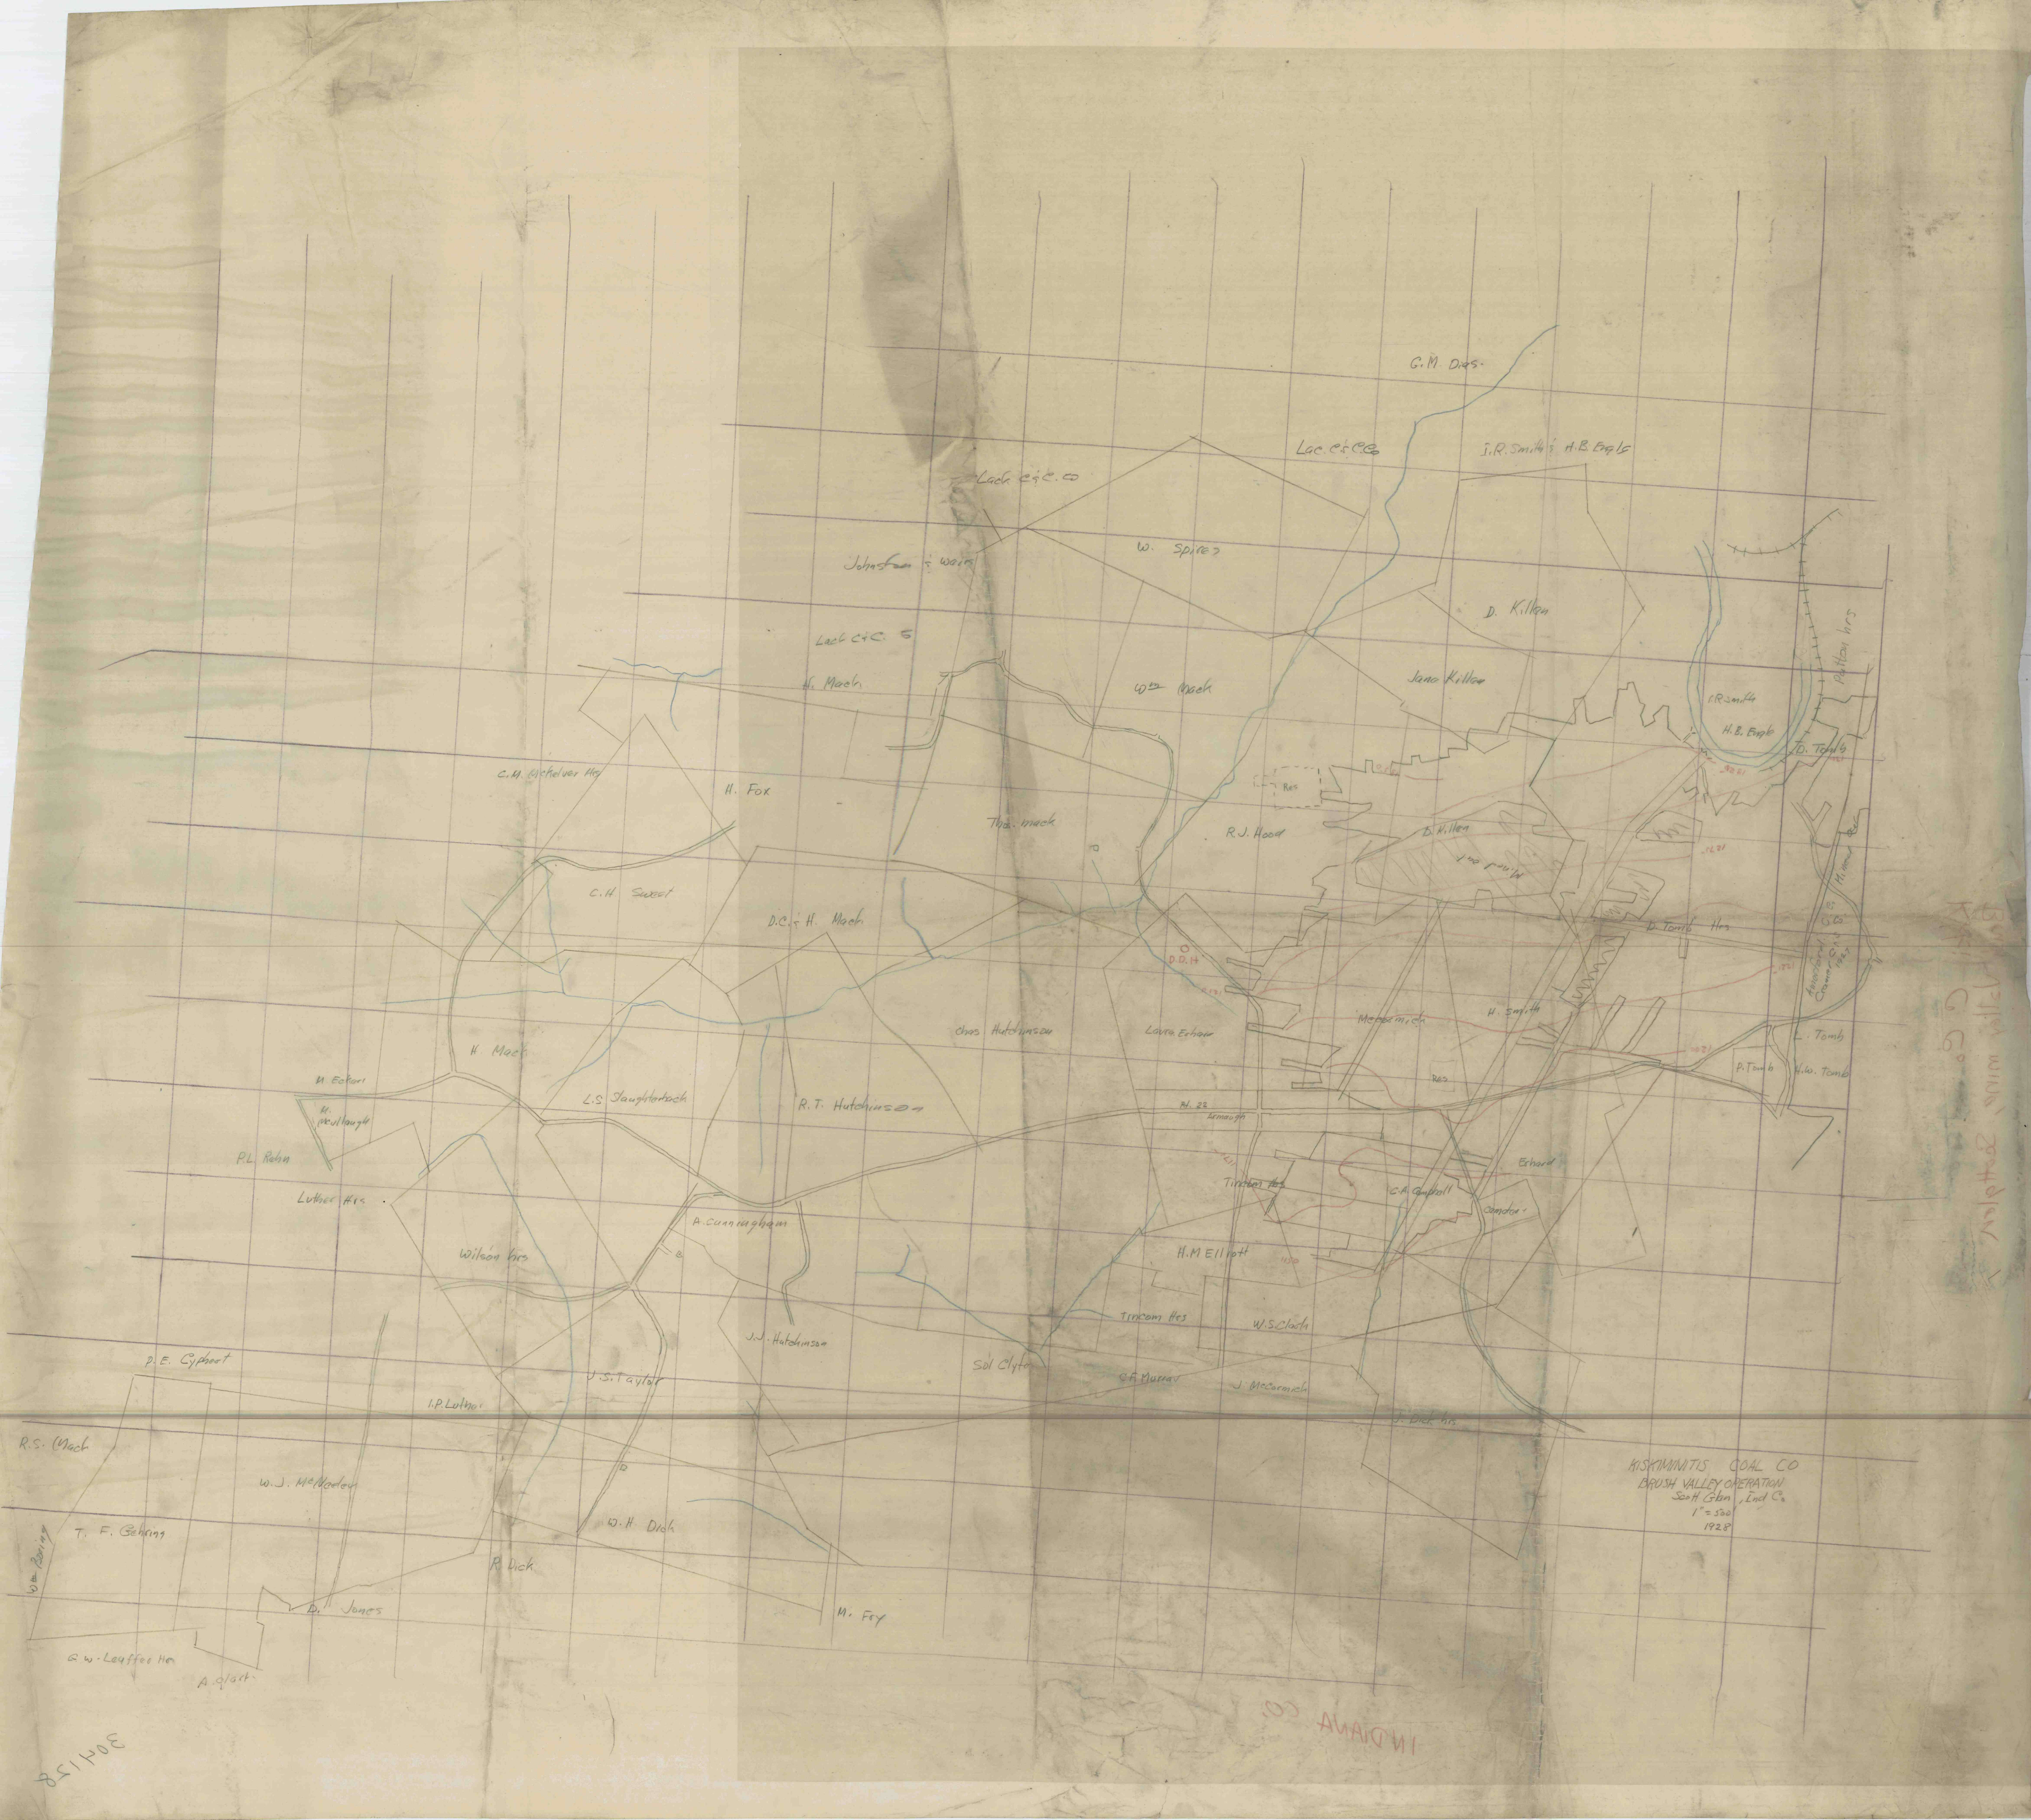

KISKIMINITIS COAL CO
BRUSH VALLEY OPERATION
Scott Glen, Ind Co.
1" = 500'
1928
G.M. Dias.
Lac. C&C Co
J.R. Smith & H.B. Eagle
Lach C&C Co
W. Spires
Johnston & weir
D. Killen
Lach C&C. Co
Jane Killen
H. Mach
Wm Mach
C.M. McKelvey Hrs
H. Fox
Thos. mach
R.J. Hood
D. Killen
C.H. Sweet
D.C. & H. Mach
D. Tomb Hrs
Chas. Hutchinson
Laura Eckhart
McCormick
H. Smith
L. Tomb
P. Tomb
H.W. Tomb
H. Mach
M. Eckart
H. Mcculough
L.S. Slaughterback
R.T. Hutchinson
P.L. Rahm
Luther Hrs
Timmons Hrs
Eckart
C.A. Campbell
A. Cunningham
Wilson Hrs
H.M. Elliott
Timmons Hrs
W.S. Clark
J.W. Hutchinson
P.E. Cyphert
J.S. Taylor
Sol Clyde
C.F. Murray
J. McCormick
I.P. Luther
R.S. Mach
W.J. McMorley
T. F. Gehring
W.H. Dick
P. Dick
D. Jones
M. Fry
G.W. Leaffer Hrs
A. Clark
H.B. Eagle
D. Tomb
INDIANA CO.
304128