


FT. TO SHEET 502

CLYDE MINE SHEET 501

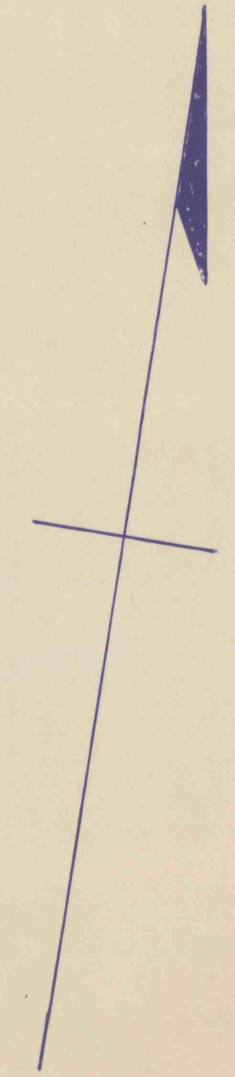

CLYDE MINE  
I.T.E.C.

EAST BETHLEHEM & WEST BETHLEHEM TOWNSHIPS & DEEMSTON BORO.  
WASHINGTON CO. PA.  
MORGAN-JEFFERSON & WASHINGTON TOWNSHIPS & CLARKVILLE BORO.  
GREENE CO. PA.

SCALE 1"=500' SURVEY EXTENDED TO 11/2/94  
ID. NO. 36-00967 MINE BOUNDARY MAPS