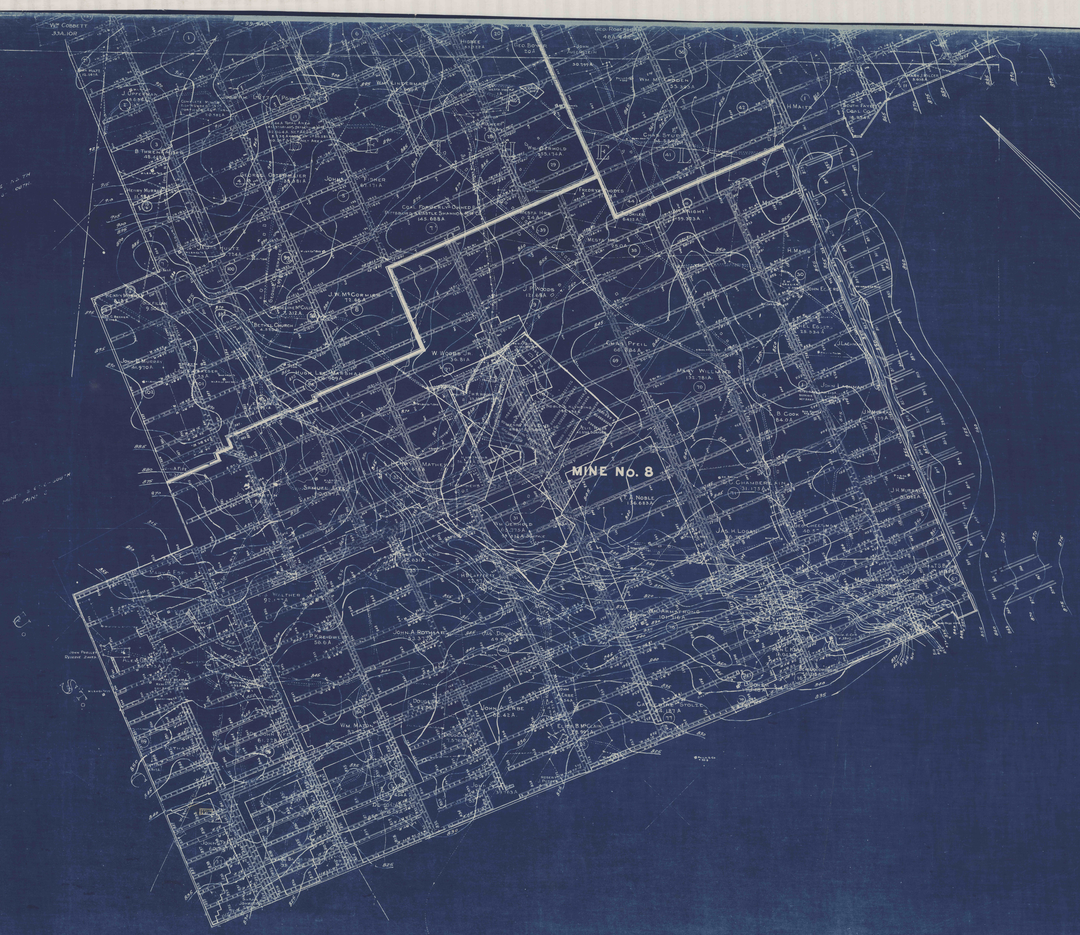


# Map of
# Coal Lands
## Owned By
## PGH. TERMINAL COAL CORPORATION
Situated In
Baldwin, Bethel, Jefferson, Mt. Lebanon, Snowden, Upper St. Clair
Twps., Castle Shannon, Overbrook Boros., Allegheny County, Penna.
Scale 1in.=500ft. May 1926