

FORMERLY
FOECENT


LINCOLN GAS COAL COMPANY

COAL PROPERTIES IN NORTH AND SOUTH FRANKLIN
BUFFALO & CANTON TOWNSHIPS

JOSEPH S. FARLAND

FILE
542

PHOTO SCALE: 1"=500' ±

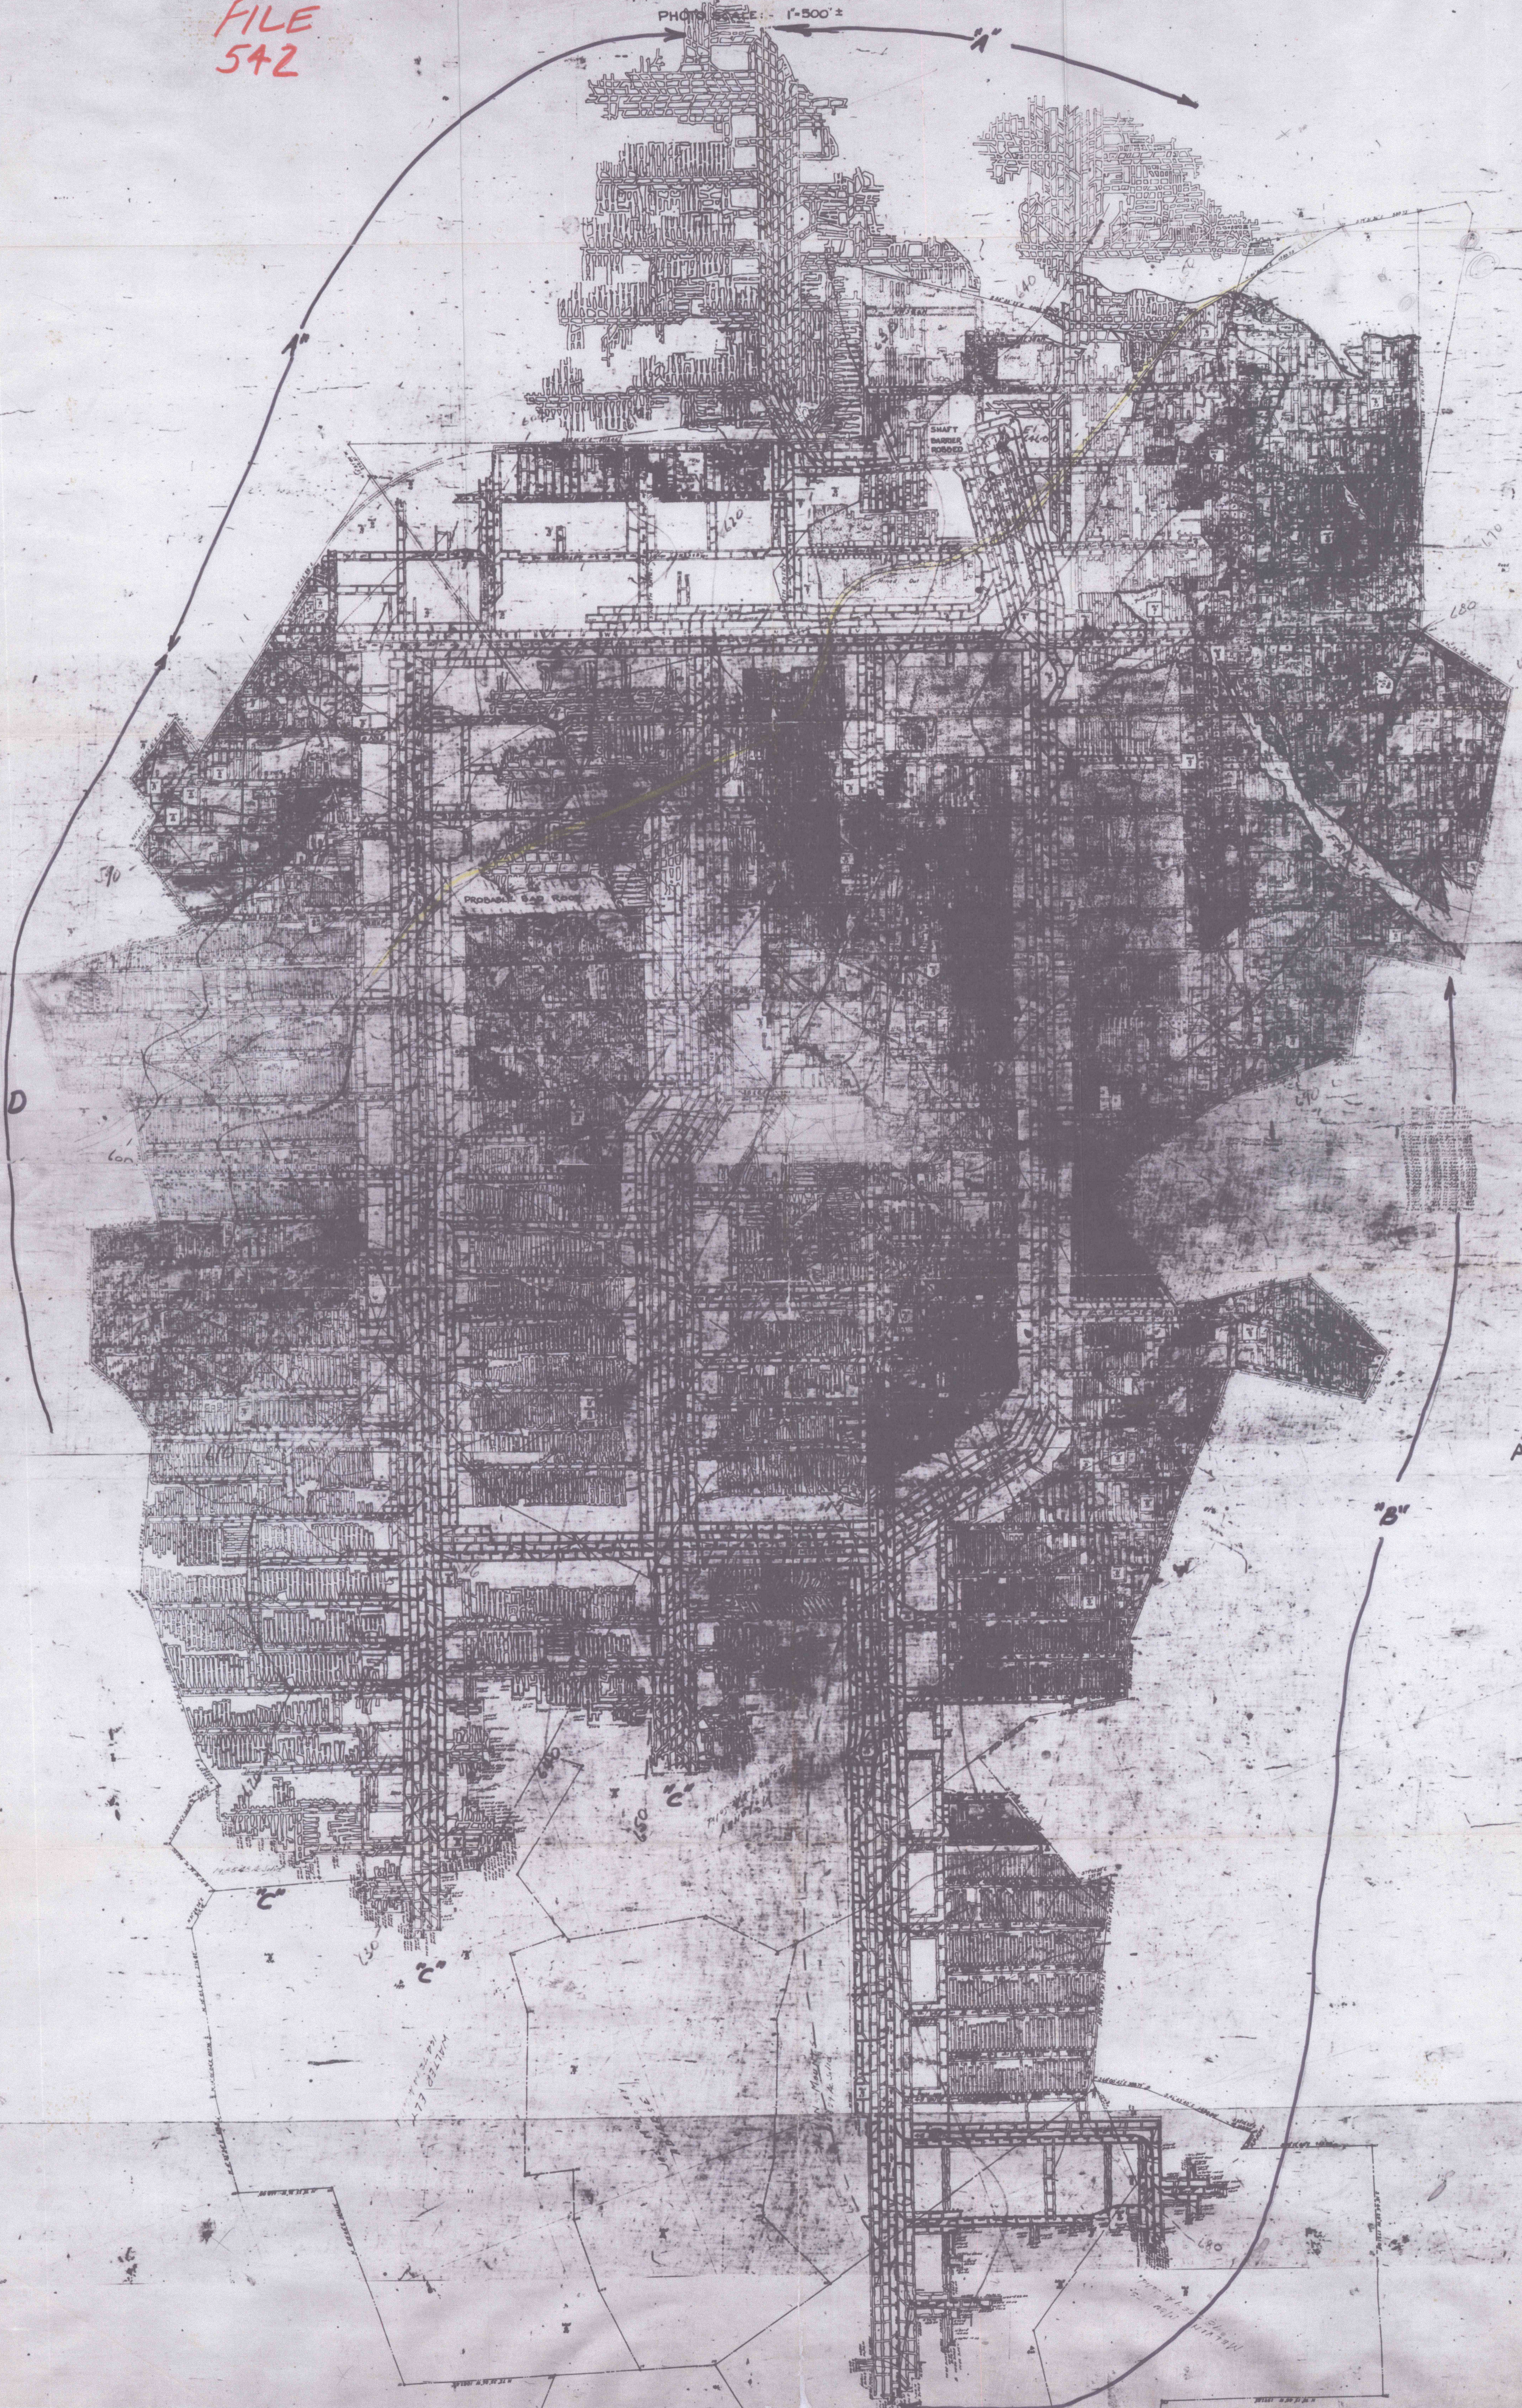

AR-233

"B"

D

"C"

UNITED STATES
GEOLOGICAL SURVEY