


Clyde
mine
maps
(sealing)

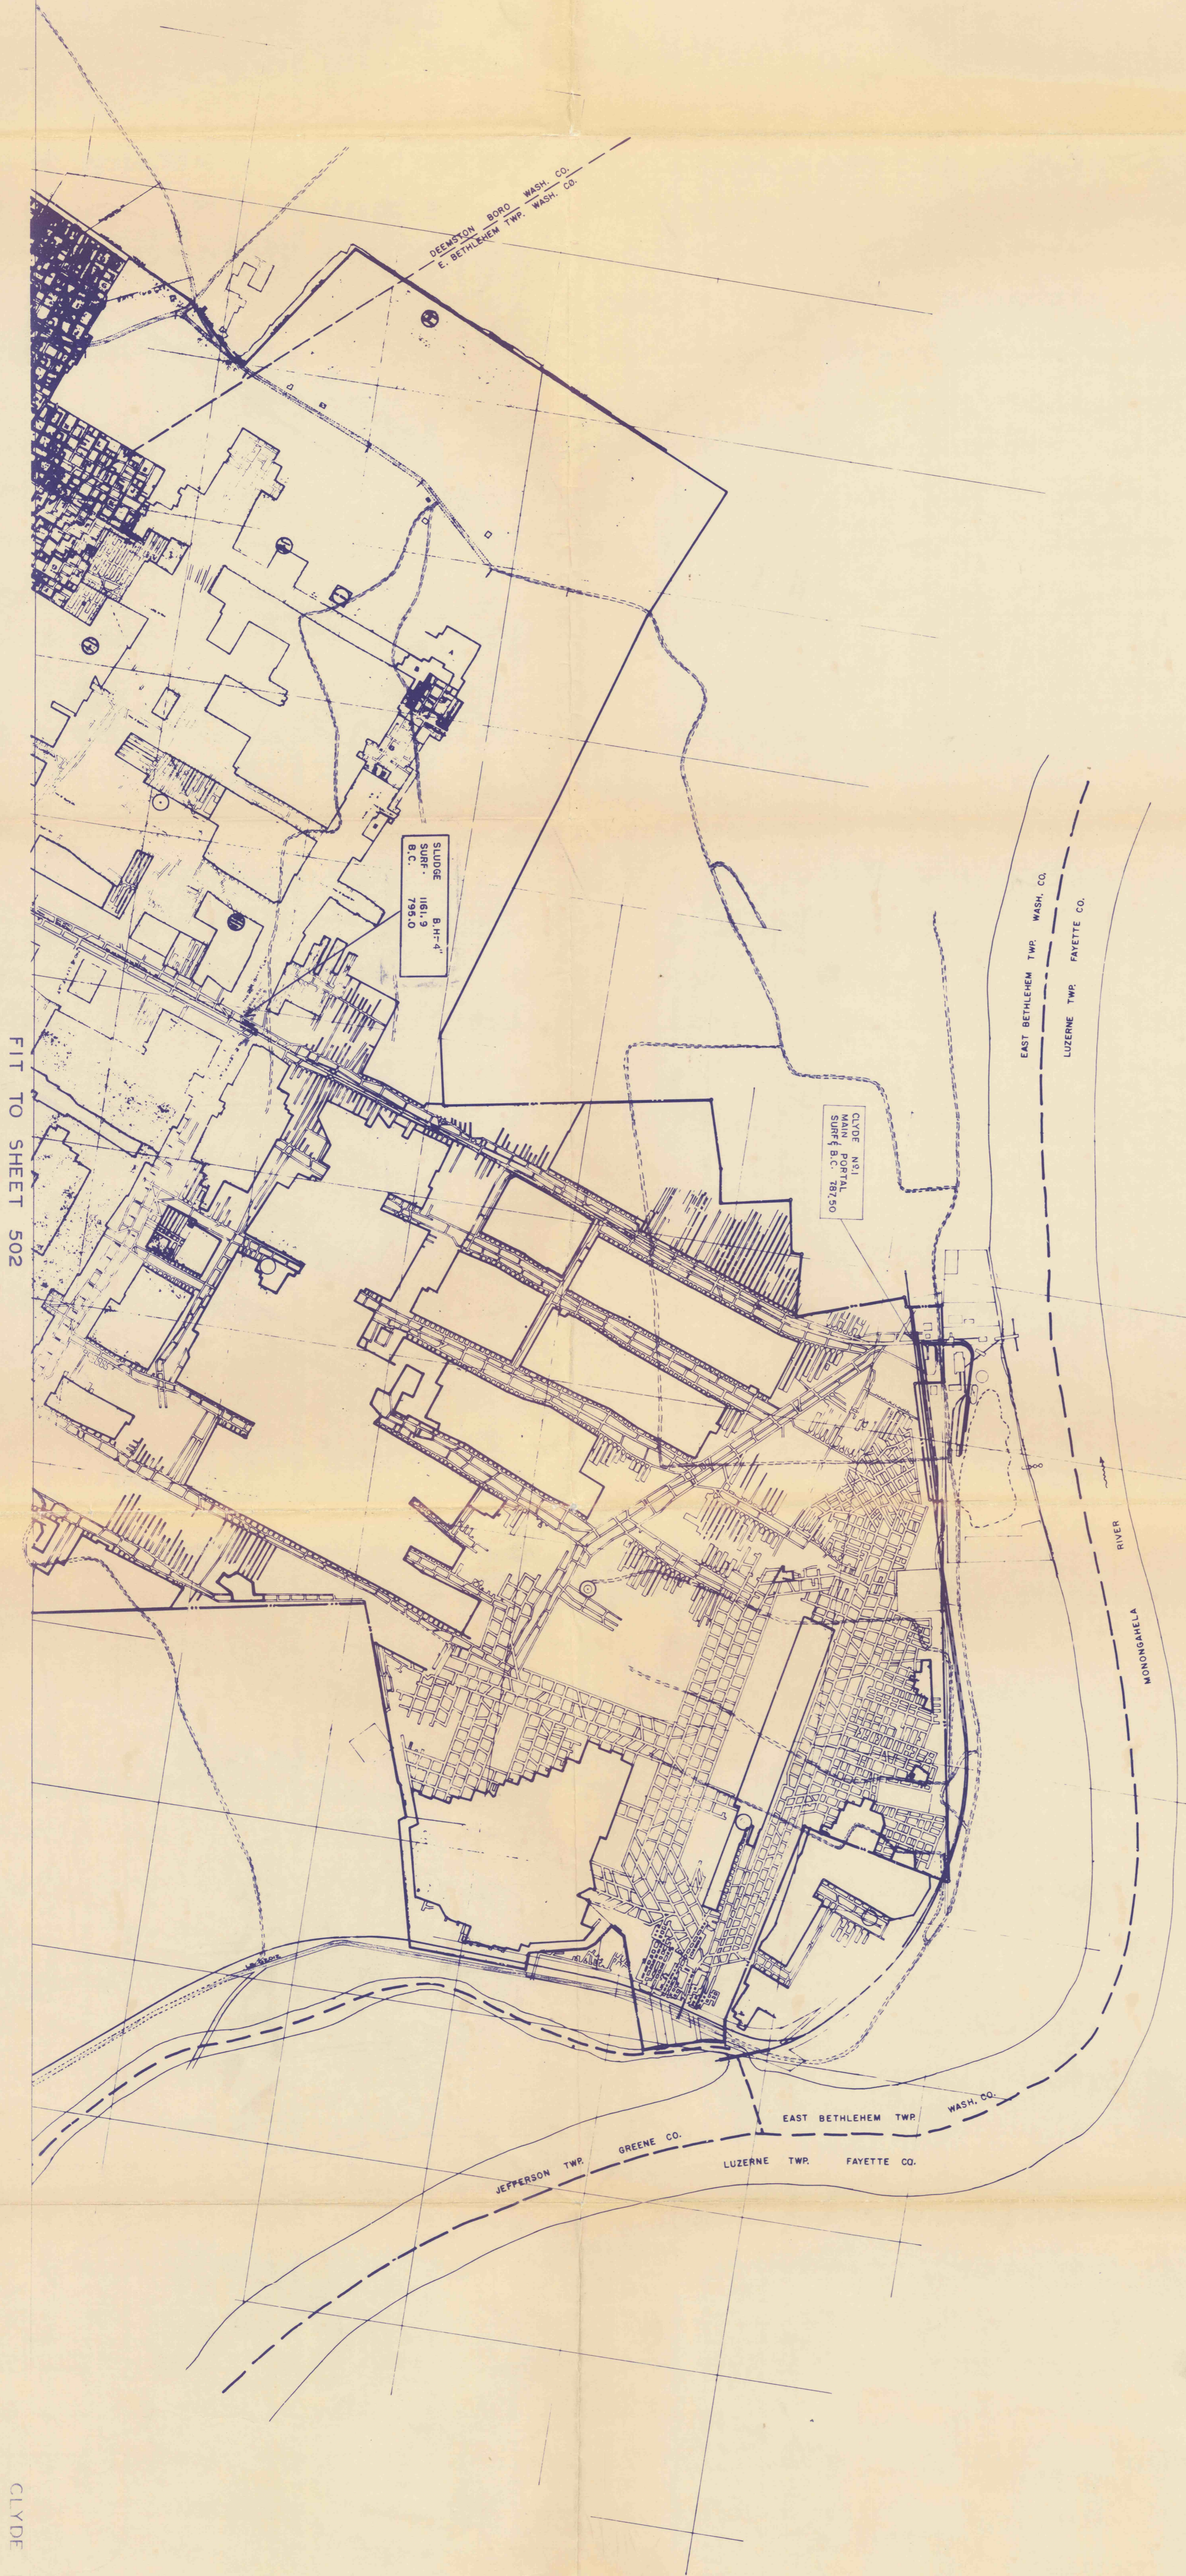

FIT TO SHEET 502

CLYDE MINE SHEET 501

CLYDE MINE
I.T.E.C.

EAST BETHLEHEM & WEST BETHLEHEM TWPS. & DEEMSTON BORO.
WASHINGTON CO. PA.
MORGAN - JEFFERSON & WASHINGTON TWPS & CLARKVILLE BORO.
GREENE CO. PA.

SCALE 1"=500' SURVEY EXTENDED TO 10/24/02

(1)