

MUNSTER TWP.  
SUMMERHILL TWP.

PORTAGE TWP.  
SUMMERHILL TWP.

NORTH BRANCH  
CONEMAUGH RESERVOIR OF THE  
MANUFACTURING WATER SUPPLY CO.  
(BERTHLEEM STEEL COMPANY)

10" POWER S.H. 332' DEEP  
LYONH SUBSTA. NO. 3  
1-200 KW M.G.

PENNA. R.R. BARRIER

N. 16000

N. 14000

N. 12000

N. 10000

N. 8000


N. 6000

N. 4000

N. 2000

N. 500

N. 300

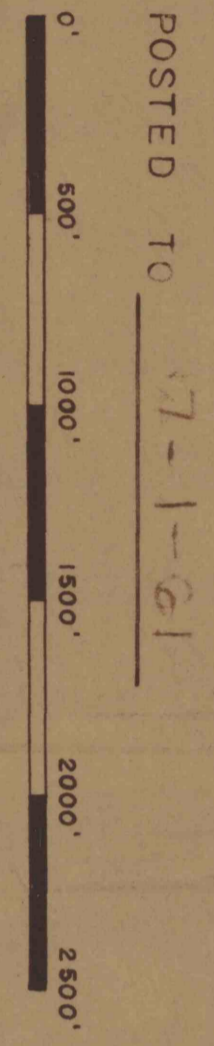

|      |             |            |      |          |
|------|-------------|------------|------|----------|
| REV. | DESCRIPTION | CHECKED BY | DATE | APPROVED |
|      |             |            |      |          |


SCALE 1" = 500'

PROJECTION IN "E" OR UPPER MERIDIAN SEAM

EASTERN GAS AND FUEL ASSOCIATES  
COAL DIVISION  
PITTSBURGH, PA.

CAMBRIA COUNTY

L-5-262  
SHEET NO. 1 OF 3 SHEETS

