


WILLIAMS RIVER COAL COMPANY CRICHTON NO. 5 MINE

FORK LICK AND GLADE DISTRICTS
WEBSTER COUNTY - WEST VIRGINIA
SCALE OF FEET

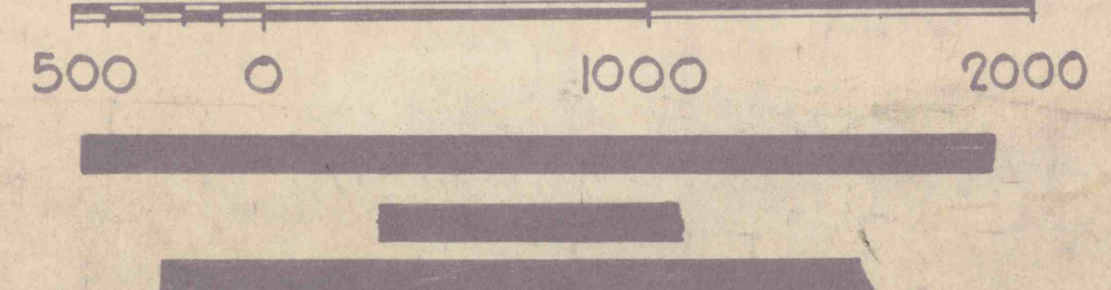

APRIL - 1949
EXTENDED TO 12 1/2