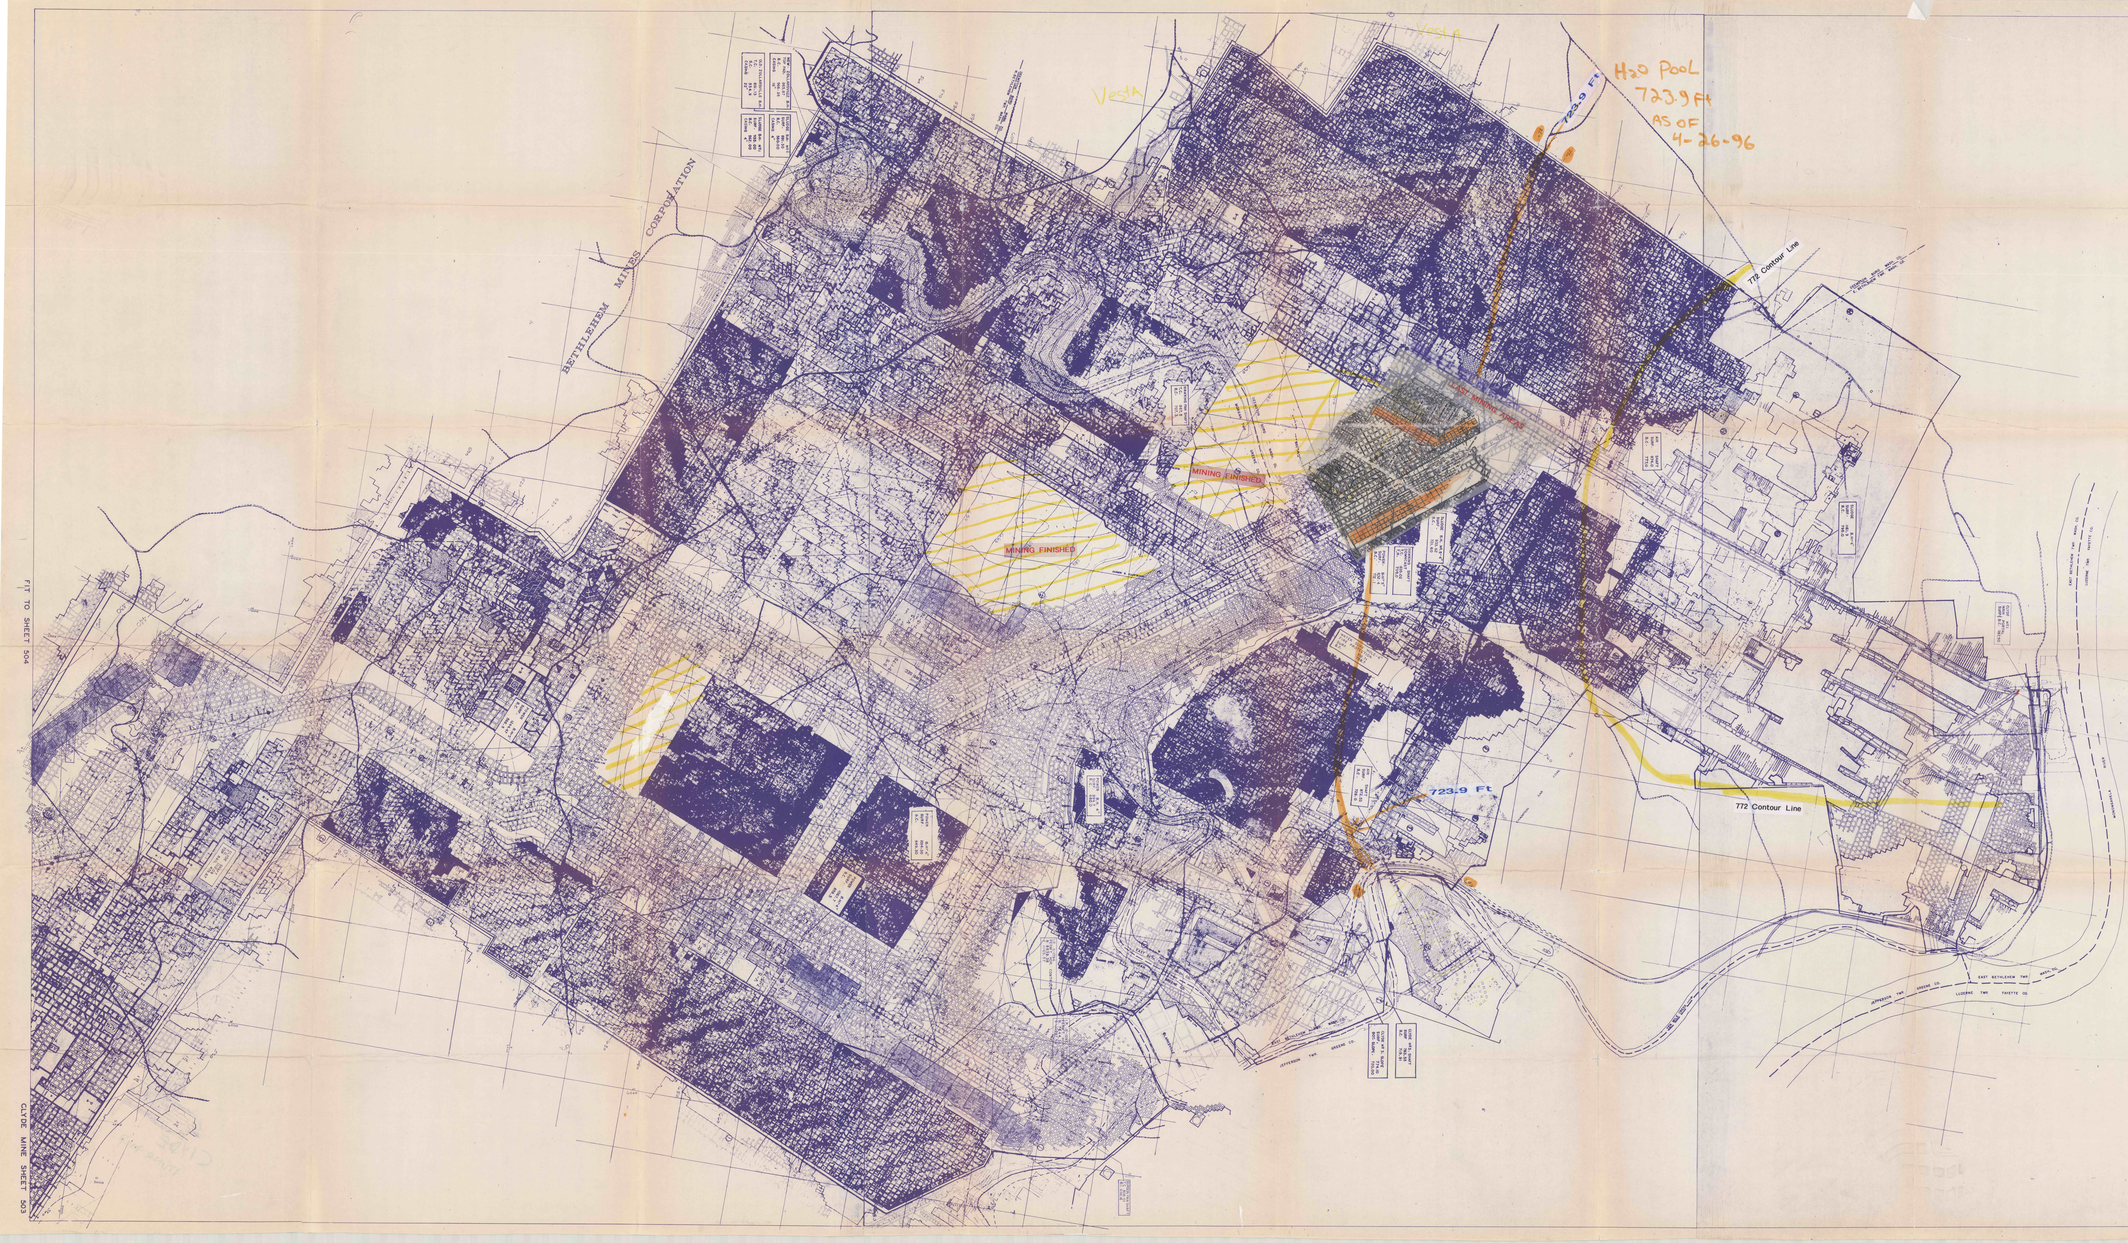

FIT TO SHEET 504

CLYDE MINE SHEET 503

CLYDE MINE SHEET 501

CLYDE MINE

BCNR MINING CORPORATION

EAST BETHLEHEM & WEST BETHLEHEM TWPS. & DEEMSTON BORO.
WASHINGTON CO. PA.

MORGAN-JEFFERSON & WASHINGTON TWPS & CLARKVILLE BORO.
GREENE CO. PA.

SCALE 1"=500' SURVEY EXTENDED TO .....