


May 24, 1930. Thomas Pealer, C.E.
Thomas Pealer

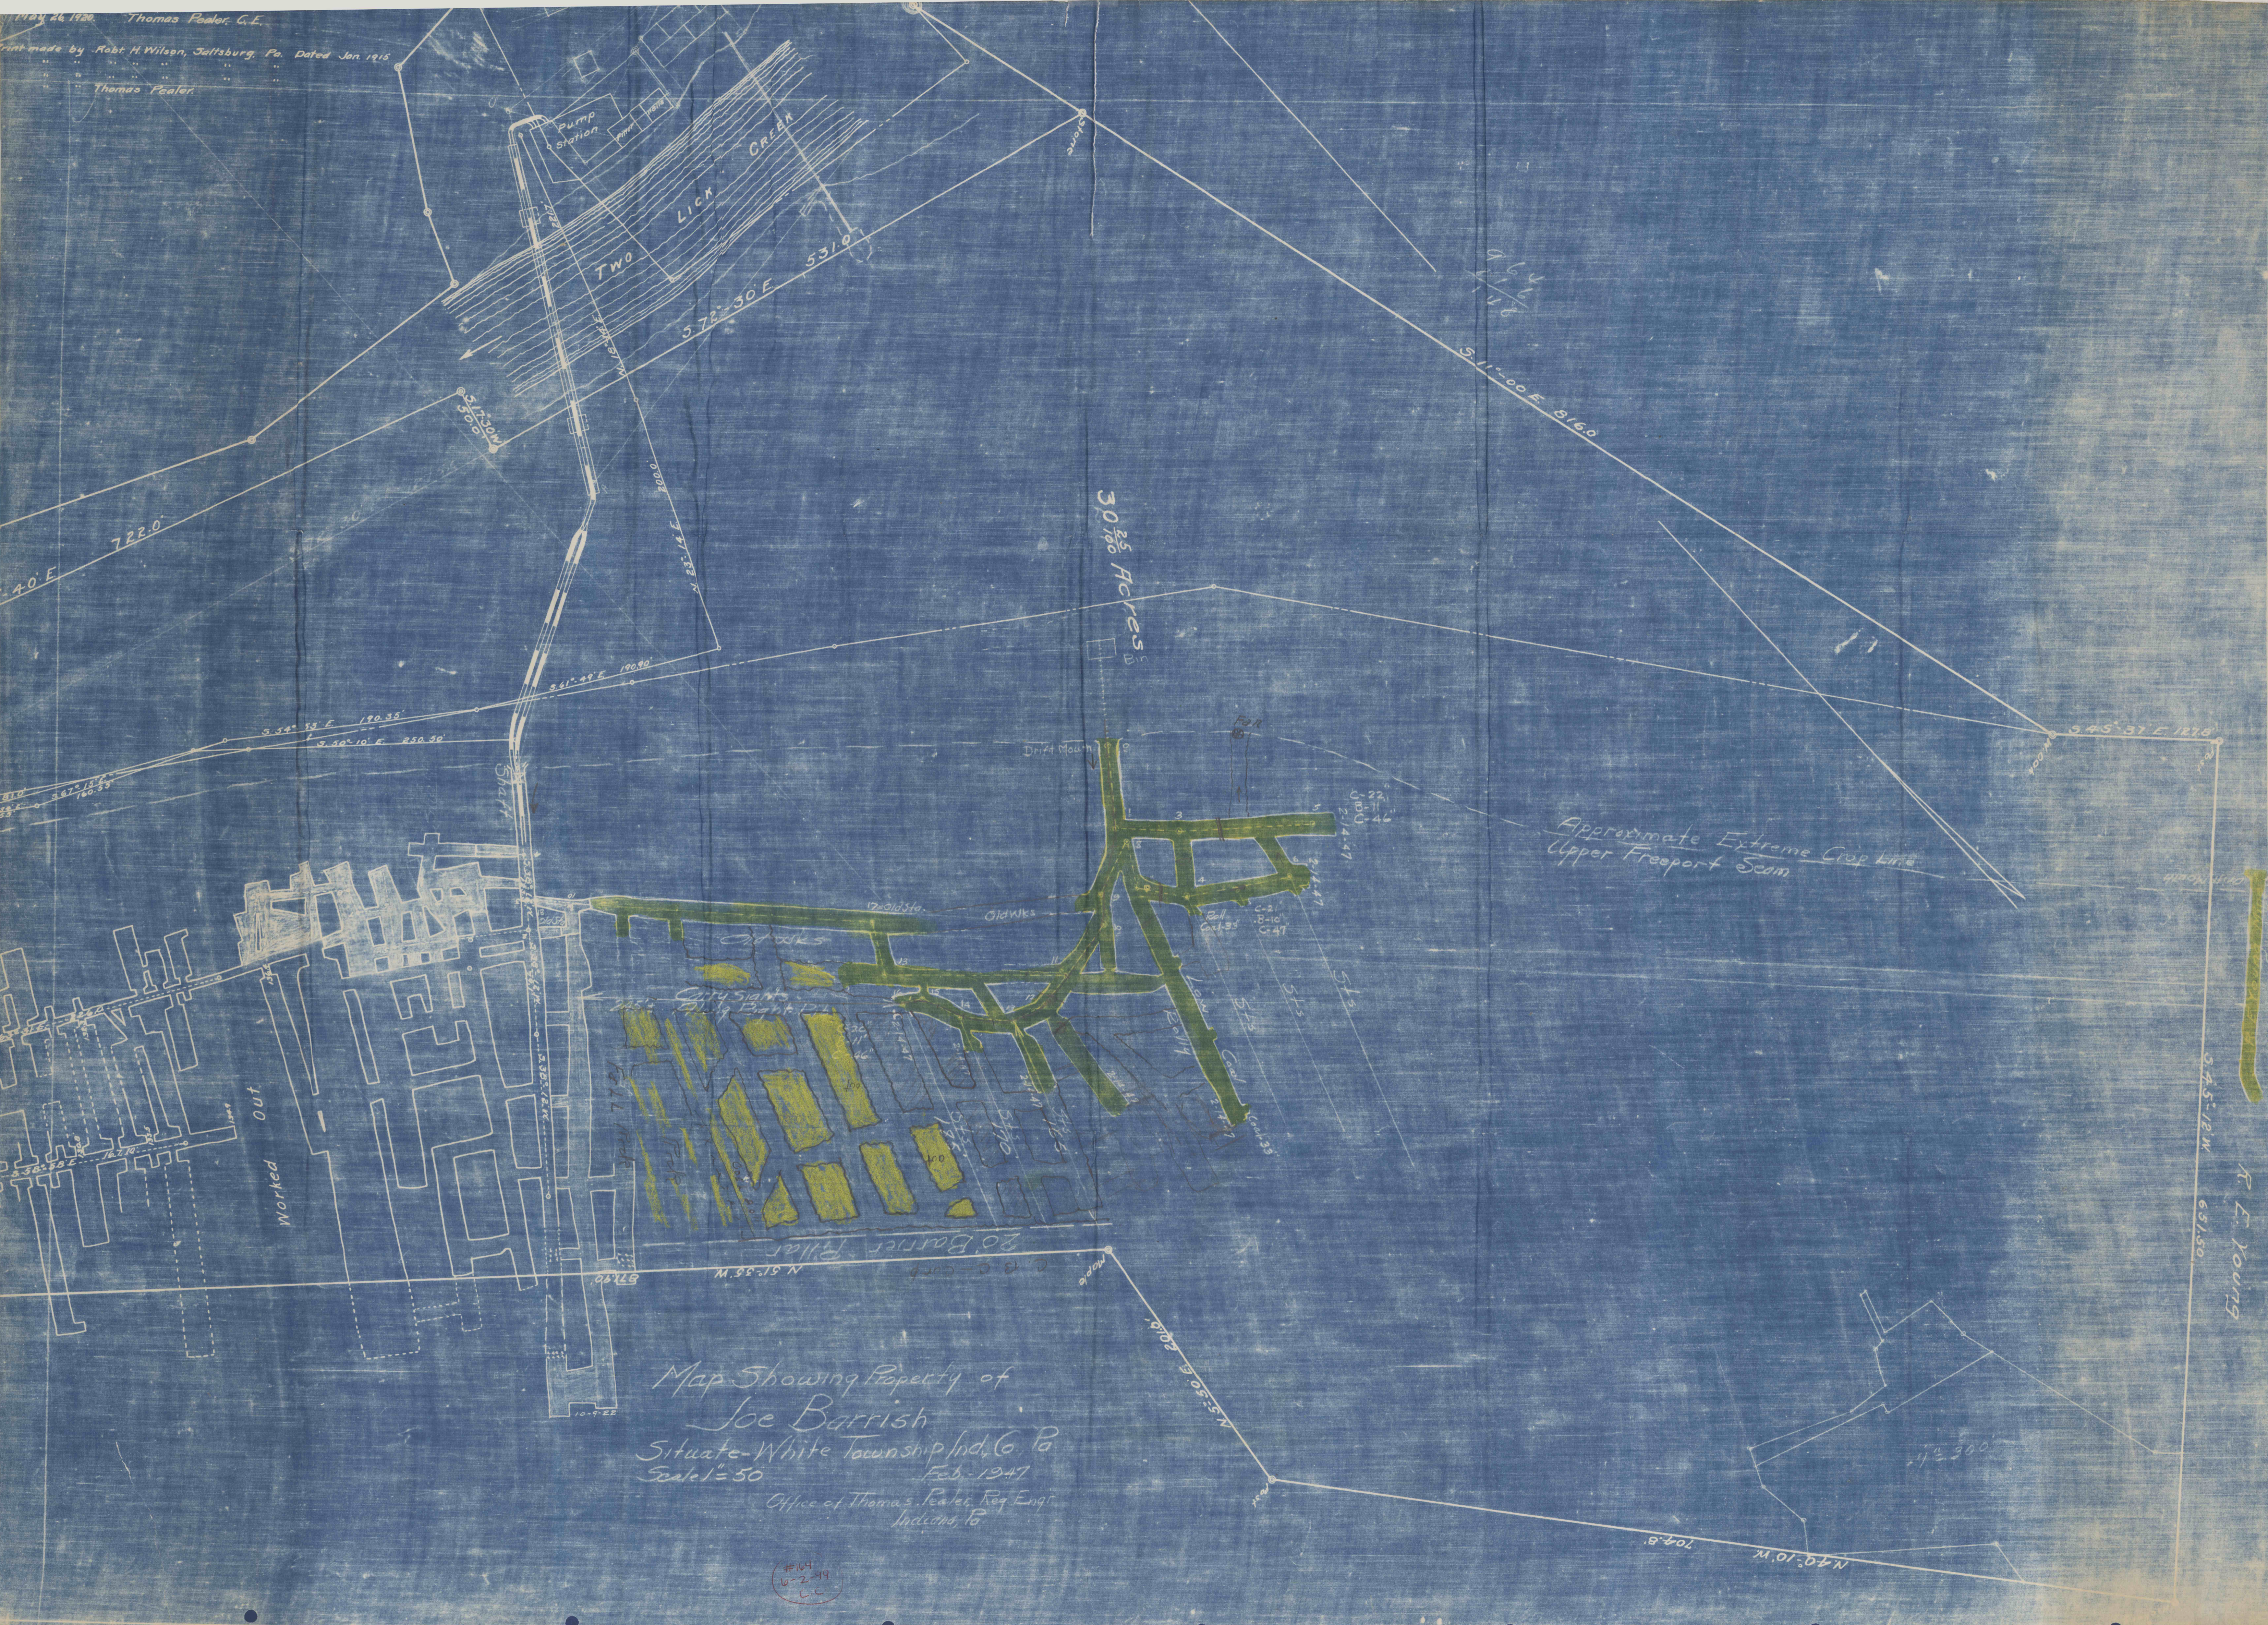

Map Showing Property of
Joe Barrish
Situate White Township Ind. Co. Pa.
Scale 1"=50' Feb. 1947
Office of Thomas Pealer, Reg. Engr.
Indiana, Pa.

#144
6-2-49
C.C.

T. E. Young