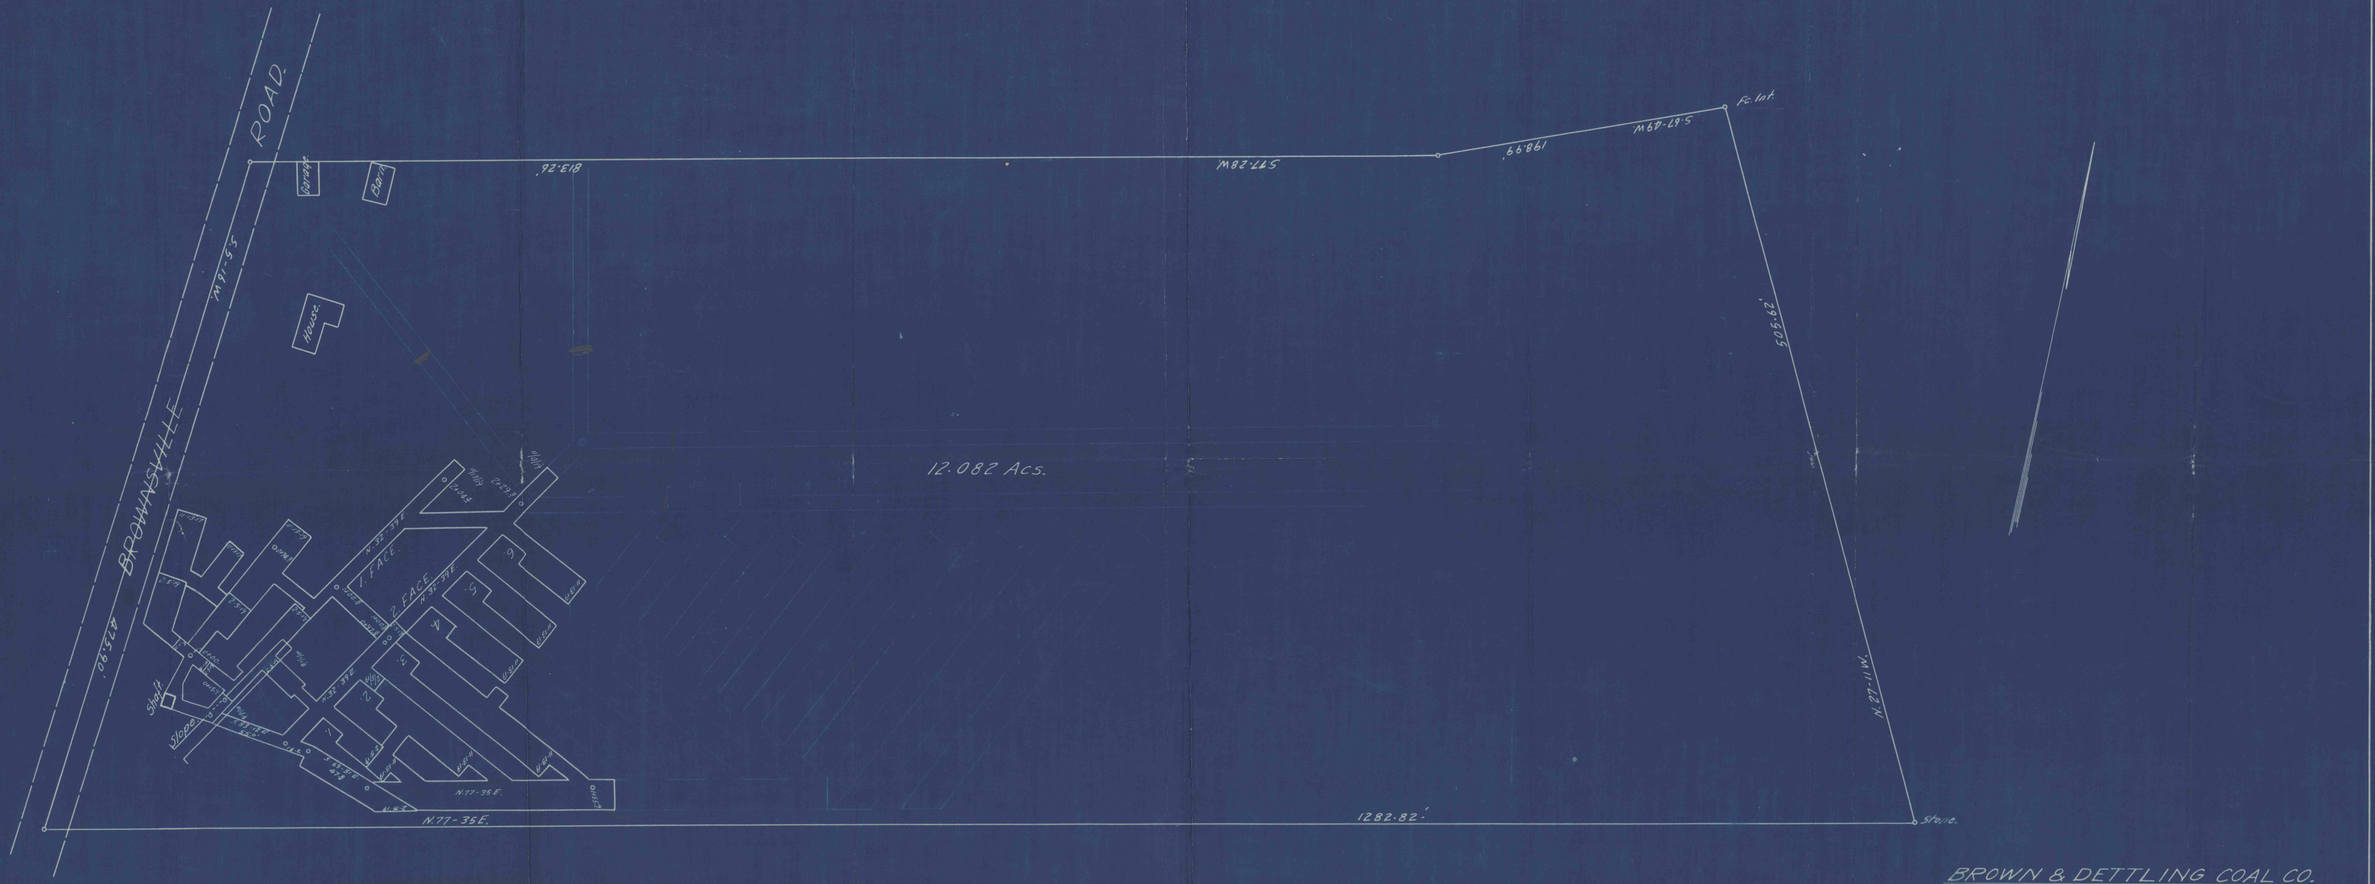

BROWN & DETTLING COAL CO.
PLAN OF COAL PROPERTY
SNOWDEN TWP ALL'Y CO. PA.
Scale 1" = 50' Oct. 4. 1918.